


1100 Wilson Boulevard

10th Floor • As Built • 19,897 SF

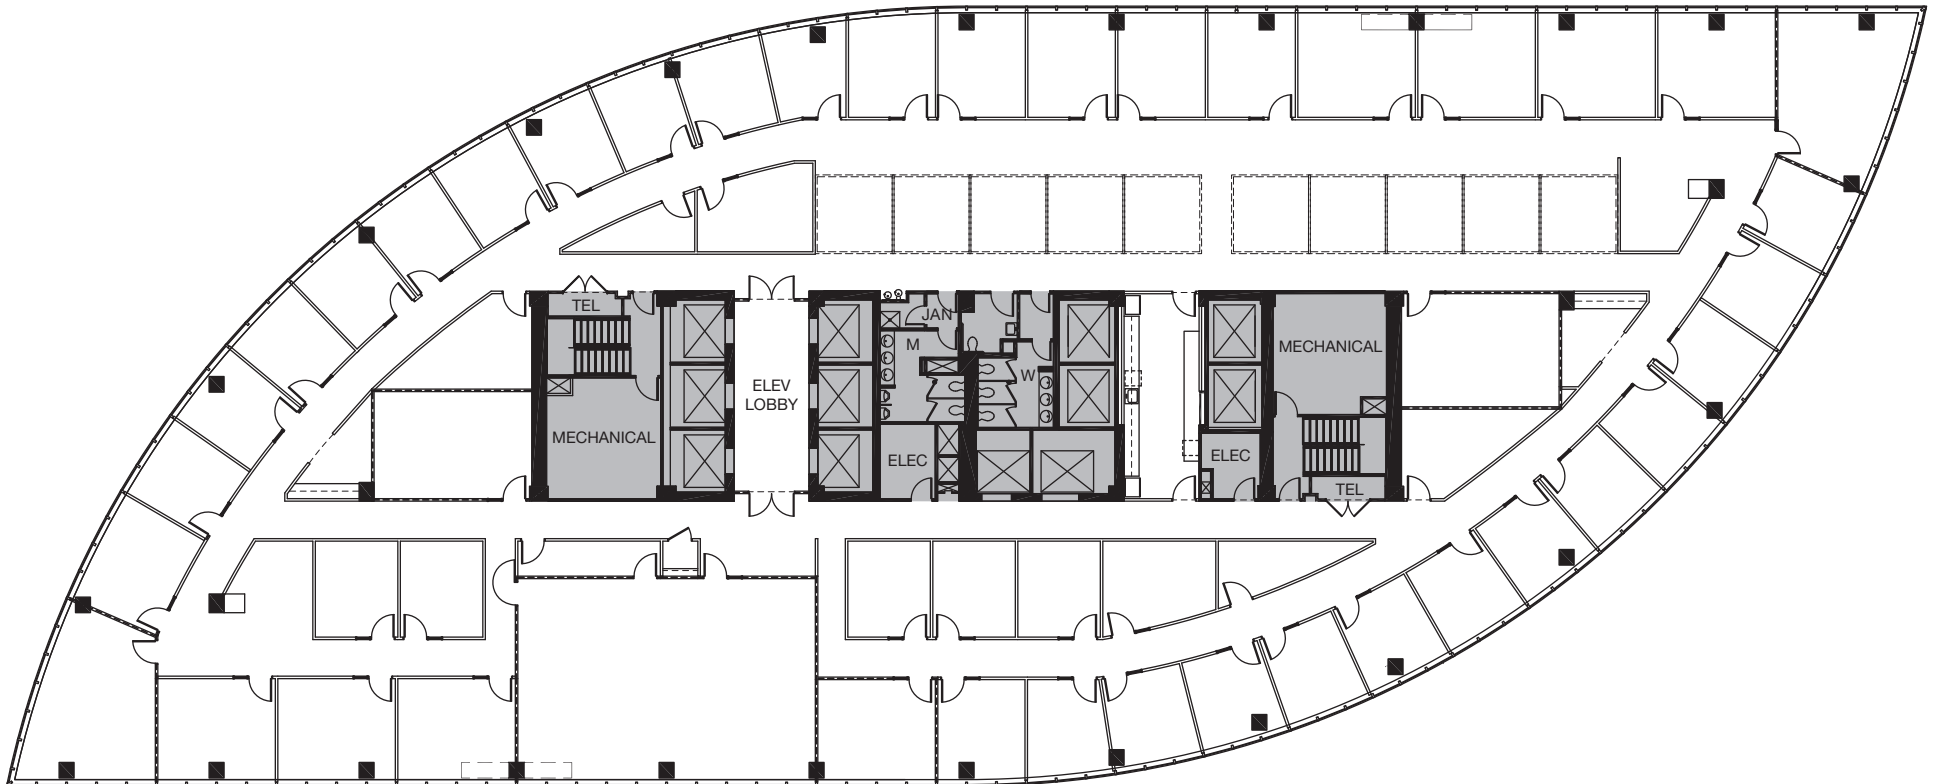

John Wharton • jwharton@mondayre.com
Andrew Thau • athau@mondayre.com
703 284 0200