


GROUND FLOOR INTERIOR AREA: 580 SQ FT  
LOWER LEVEL INTERIOR AREA: 380 SQ FT  
COVERED PATIO AREA: 190 SQ FT  
TOTAL AREA: 1,150 SQ FT

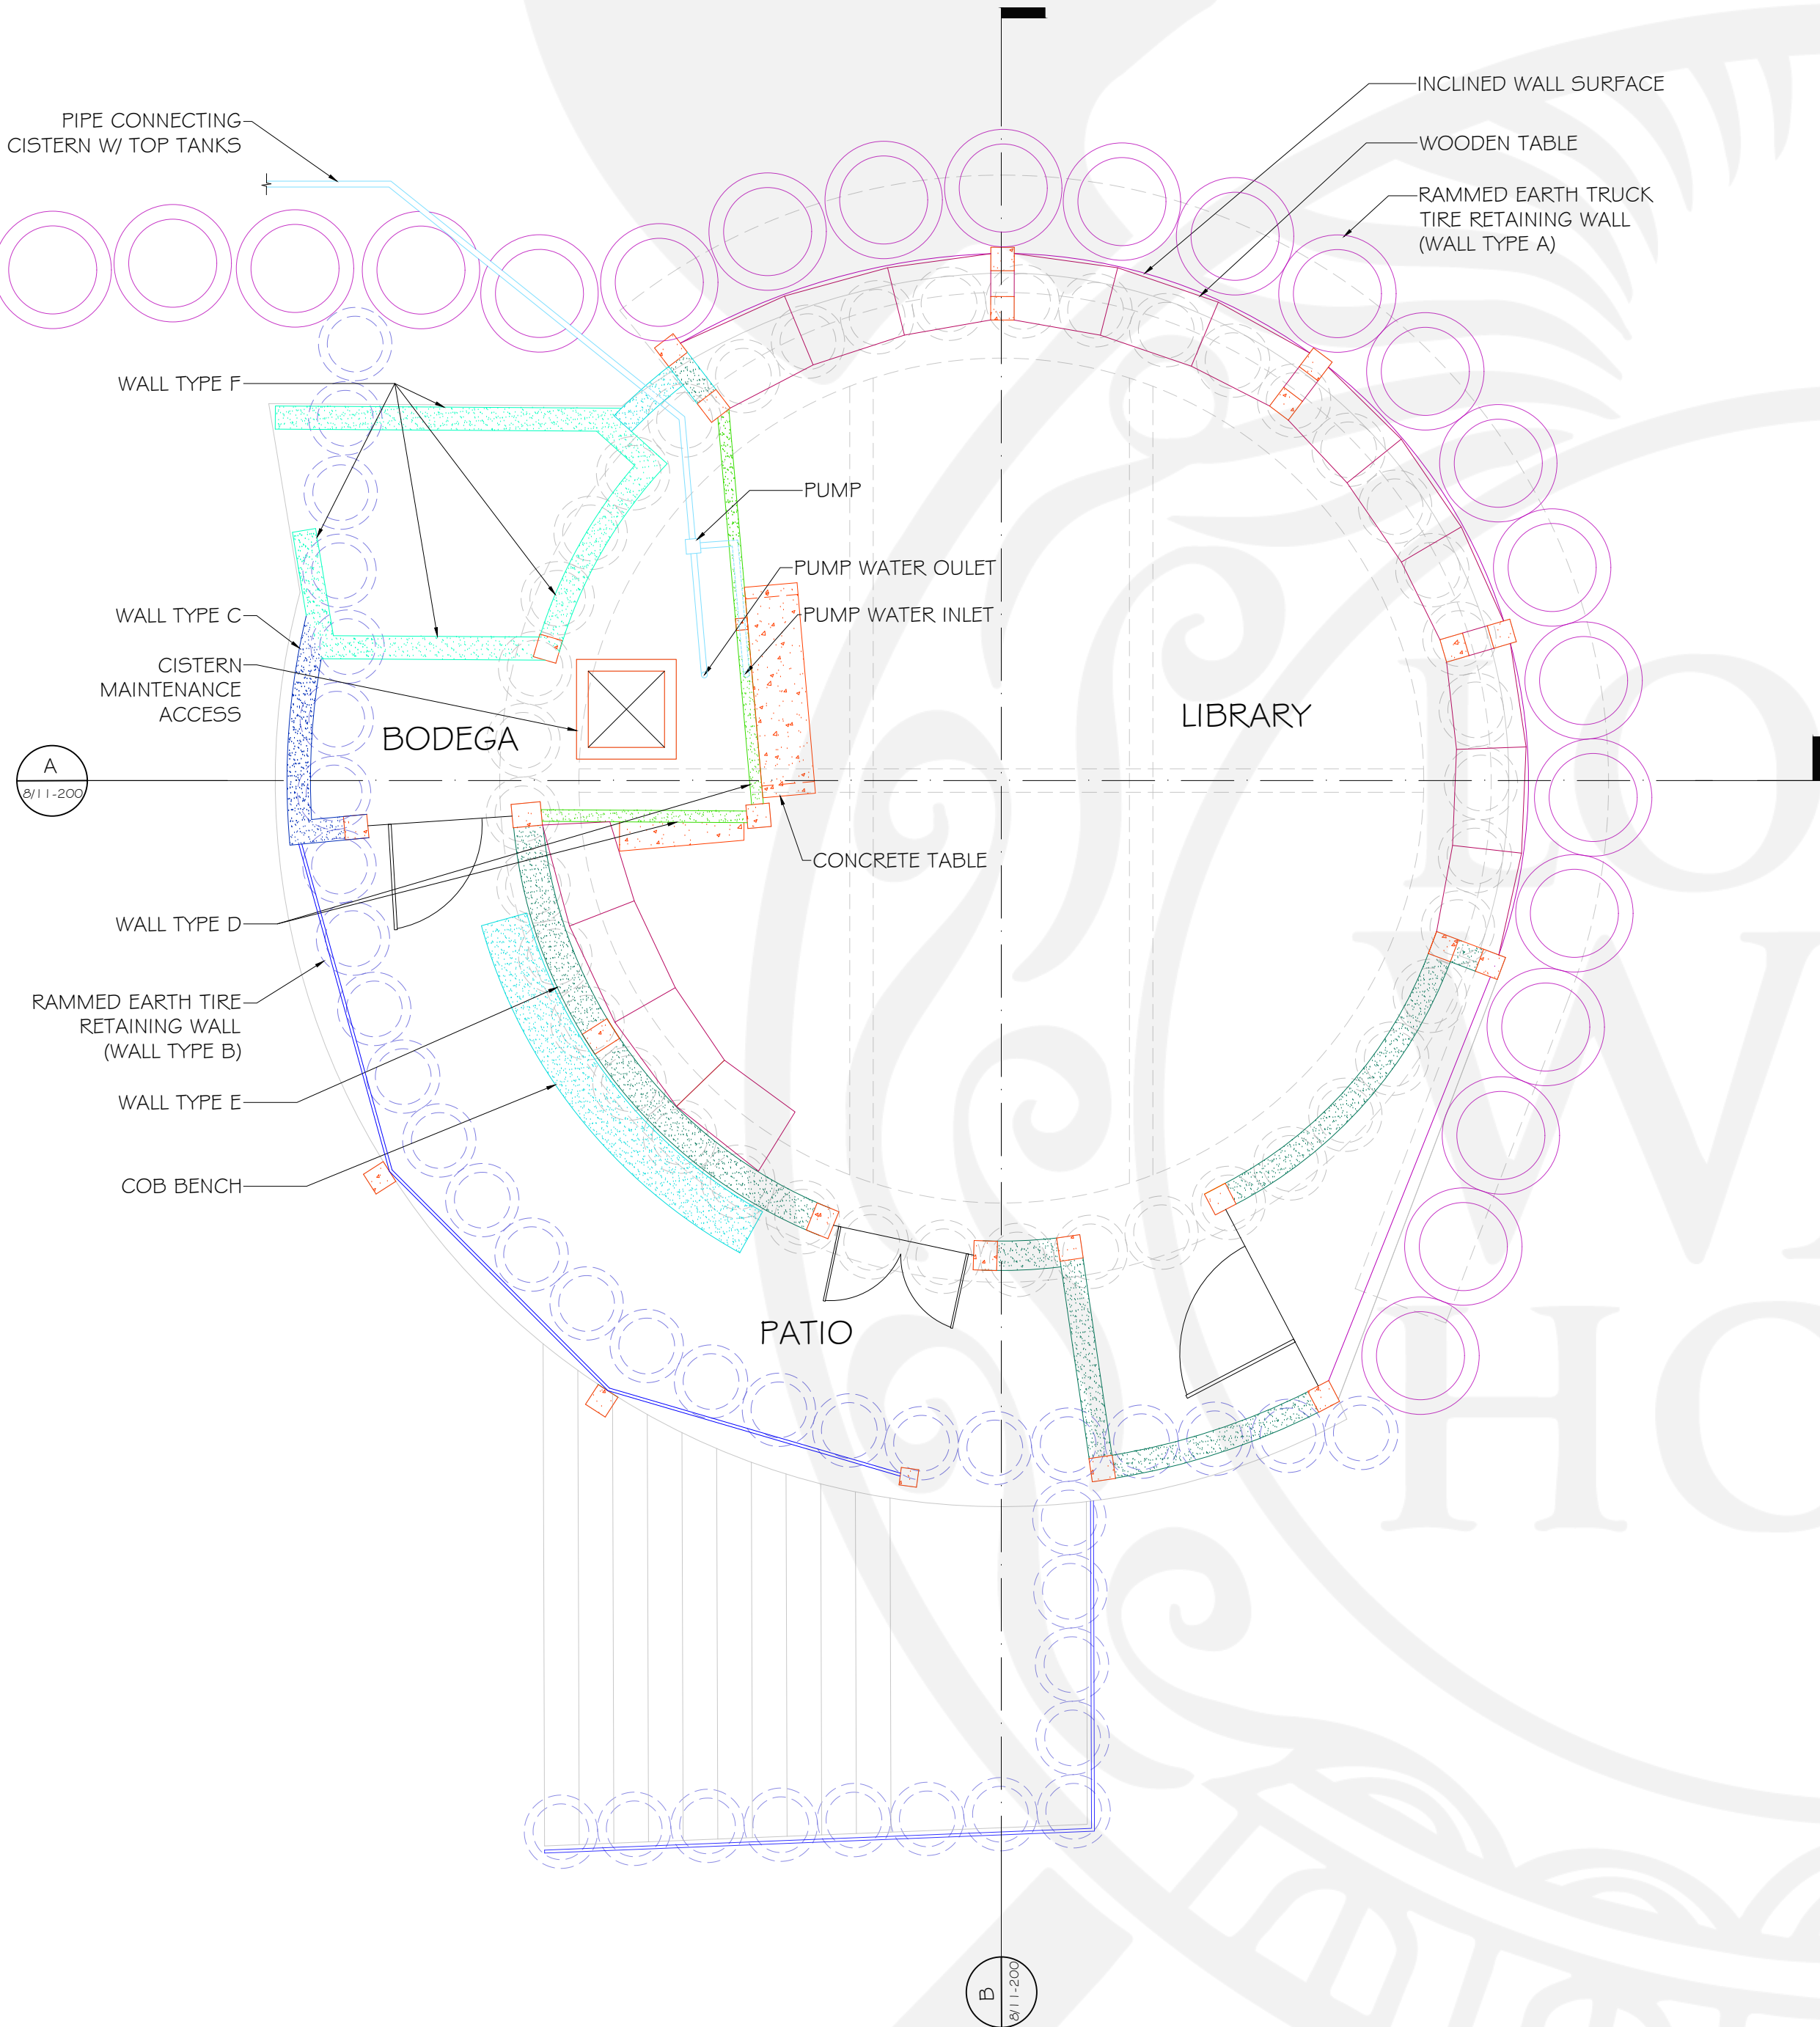

- NOTES:
1. THIS DRAWING IS A CAD DRAWING AND SHOULD NOT BE ALTERED MANUALLY.
  2. THIS DRAWING MUST NOT BE USED FOR CONSTRUCTION UNLESS APPROVED OTHERWISE.
  3. ALL DRAWINGS SHALL BE READ IN CONJUNCTION WITH ALL OTHER CONSULTANTS DRAWINGS AND SPECIFICATIONS.
  4. THIS DOCUMENT MAY ONLY BE USED BY LONG WAY HOME'S CLIENT (AND ANY OTHER PERSON WHO LWH HAS GIVEN PERMISSION TO USE THIS DOCUMENT) FOR THE PURPOSE FOR WHICH IT WAS PREPARED AND MUST NOT BE USED BY ANY OTHER PERSON OR FOR ANY OTHER PURPOSE.
  5. THIS DRAWING IS PROTECTED BY INTERNATIONAL COPYRIGHT LAW.

MATERIALS KEY:

CONCRETE	PIPES
TIRE	EARTH
COB	STEEL
TIMBER	OTHER

WALL TYPES KEY:

WALL TYPE A: RAMMED EARTH TIRES
WALL TYPE B: RAMMED EARTH TIRES
WALL TYPE C: GLASS BOTTLES + MORTAR
WALL TYPE D: ECOBRICKS + MORTAR
WALL TYPE E: COB + GLASS BOTTLES
WALL TYPE F: ECOBRICKS + MORTAR

PLAN 1 CUT AT 4' ABOVE TOP OF CONCRETE SLAB.  
PLAN 2 CUT AT TOP OF CONCRETE SLAB.

LONG WAY HOME  
SAN JUAN COMALAPA, GUATEMALA

WWW.LWHOME.ORG  
INFO@LWHOME.ORG

PROJECT:  
HERO SCHOOL  
HERO SCHOOL

BUILDING:  
42,500 GALLON  
CISTERN +  
DOME LIBRARY

NO:  
8/11

REVISIONS:			
NO.	DATE	DESC	DRAWN BY
1	05/03/2015		M.F.
2	06/05/2021	AS BUILT	S.M.

DRAWN BY:  
GERMAIN HOT

DATE:  
06 MAY 2021

SHEET TITLE:  
GROUND FLOOR  
PLANS

SCALE:  
1/4"= 1'-0"

SHEET SIZE:  
A1

SHEET NO.  
8/11-100

PAGE 1  
OF 11

1 GROUND FLOOR PLAN  
1/4"= 1'-0"







1 ROOF PLAN  
3/8" = 1'-0"

NOTES:

1. THIS DRAWING IS A CAD DRAWING AND SHOULD NOT BE ALTERED MANUALLY.
2. THIS DRAWING MUST NOT BE USED FOR CONSTRUCTION UNLESS APPROVED OTHERWISE.
3. ALL DRAWINGS SHALL BE READ IN CONJUNCTION WITH ALL OTHER CONSULTANTS DRAWINGS AND SPECIFICATIONS.
4. THIS DOCUMENT MAY ONLY BE USED BY LONG WAY HOME'S CLIENT (AND ANY OTHER PERSON WHO LWH HAS GIVEN PERMISSION TO USE THIS DOCUMENT) FOR THE PURPOSE FOR WHICH IT WAS PREPARED AND MUST NOT BE USED BY ANY OTHER PERSON OR FOR ANY OTHER PURPOSE.
5. THIS DRAWING IS PROTECTED BY INTERNATIONAL COPYRIGHT LAW.

MATERIALS KEY:

- CONCRETE
- TIRE
- TIMBER
- GLASS
- EARTH

WALL TYPES KEY:

- WALL TYPE P: ECOBRICKS + MORTAR

ALL BEAMS 1 4" HIGH  
(UNLESS NOTED OTHERWISE)

LONG WAY HOME  
SAN JUAN COMALAPA, GUATEMALA



WWW.LWHOME.ORG  
INFO@LWHOME.ORG

PROJECT:

HERO SCHOOL



HERO  
SCHOOL

BUILDING:

42,500 GALLON  
CISTERN +  
DOME LIBRARY

NO:

8/11

REVISIONS:

NO.	DATE	DESC	DRAWN BY
1	05/03/2015		M.F.
2	06/05/2021	AS BUILT	S.M.

DRAWN BY:

GERMAIN HOT

DATE:

06 MAY 2021

SHEET TITLE:

ROOF PLAN

SCALE:

3/8" = 1'-0"

SHEET SIZE:

A1


SHEET NO.

8/11-101

PAGE 2  
OF 11



GROUND FLOOR INTERIOR AREA: 580 SQ FT  
LOWER LEVEL INTERIOR AREA: 380 SQ FT  
COVERED PATIO AREA: 190 SQ FT  
TOTAL AREA: 1,150 SQ FT

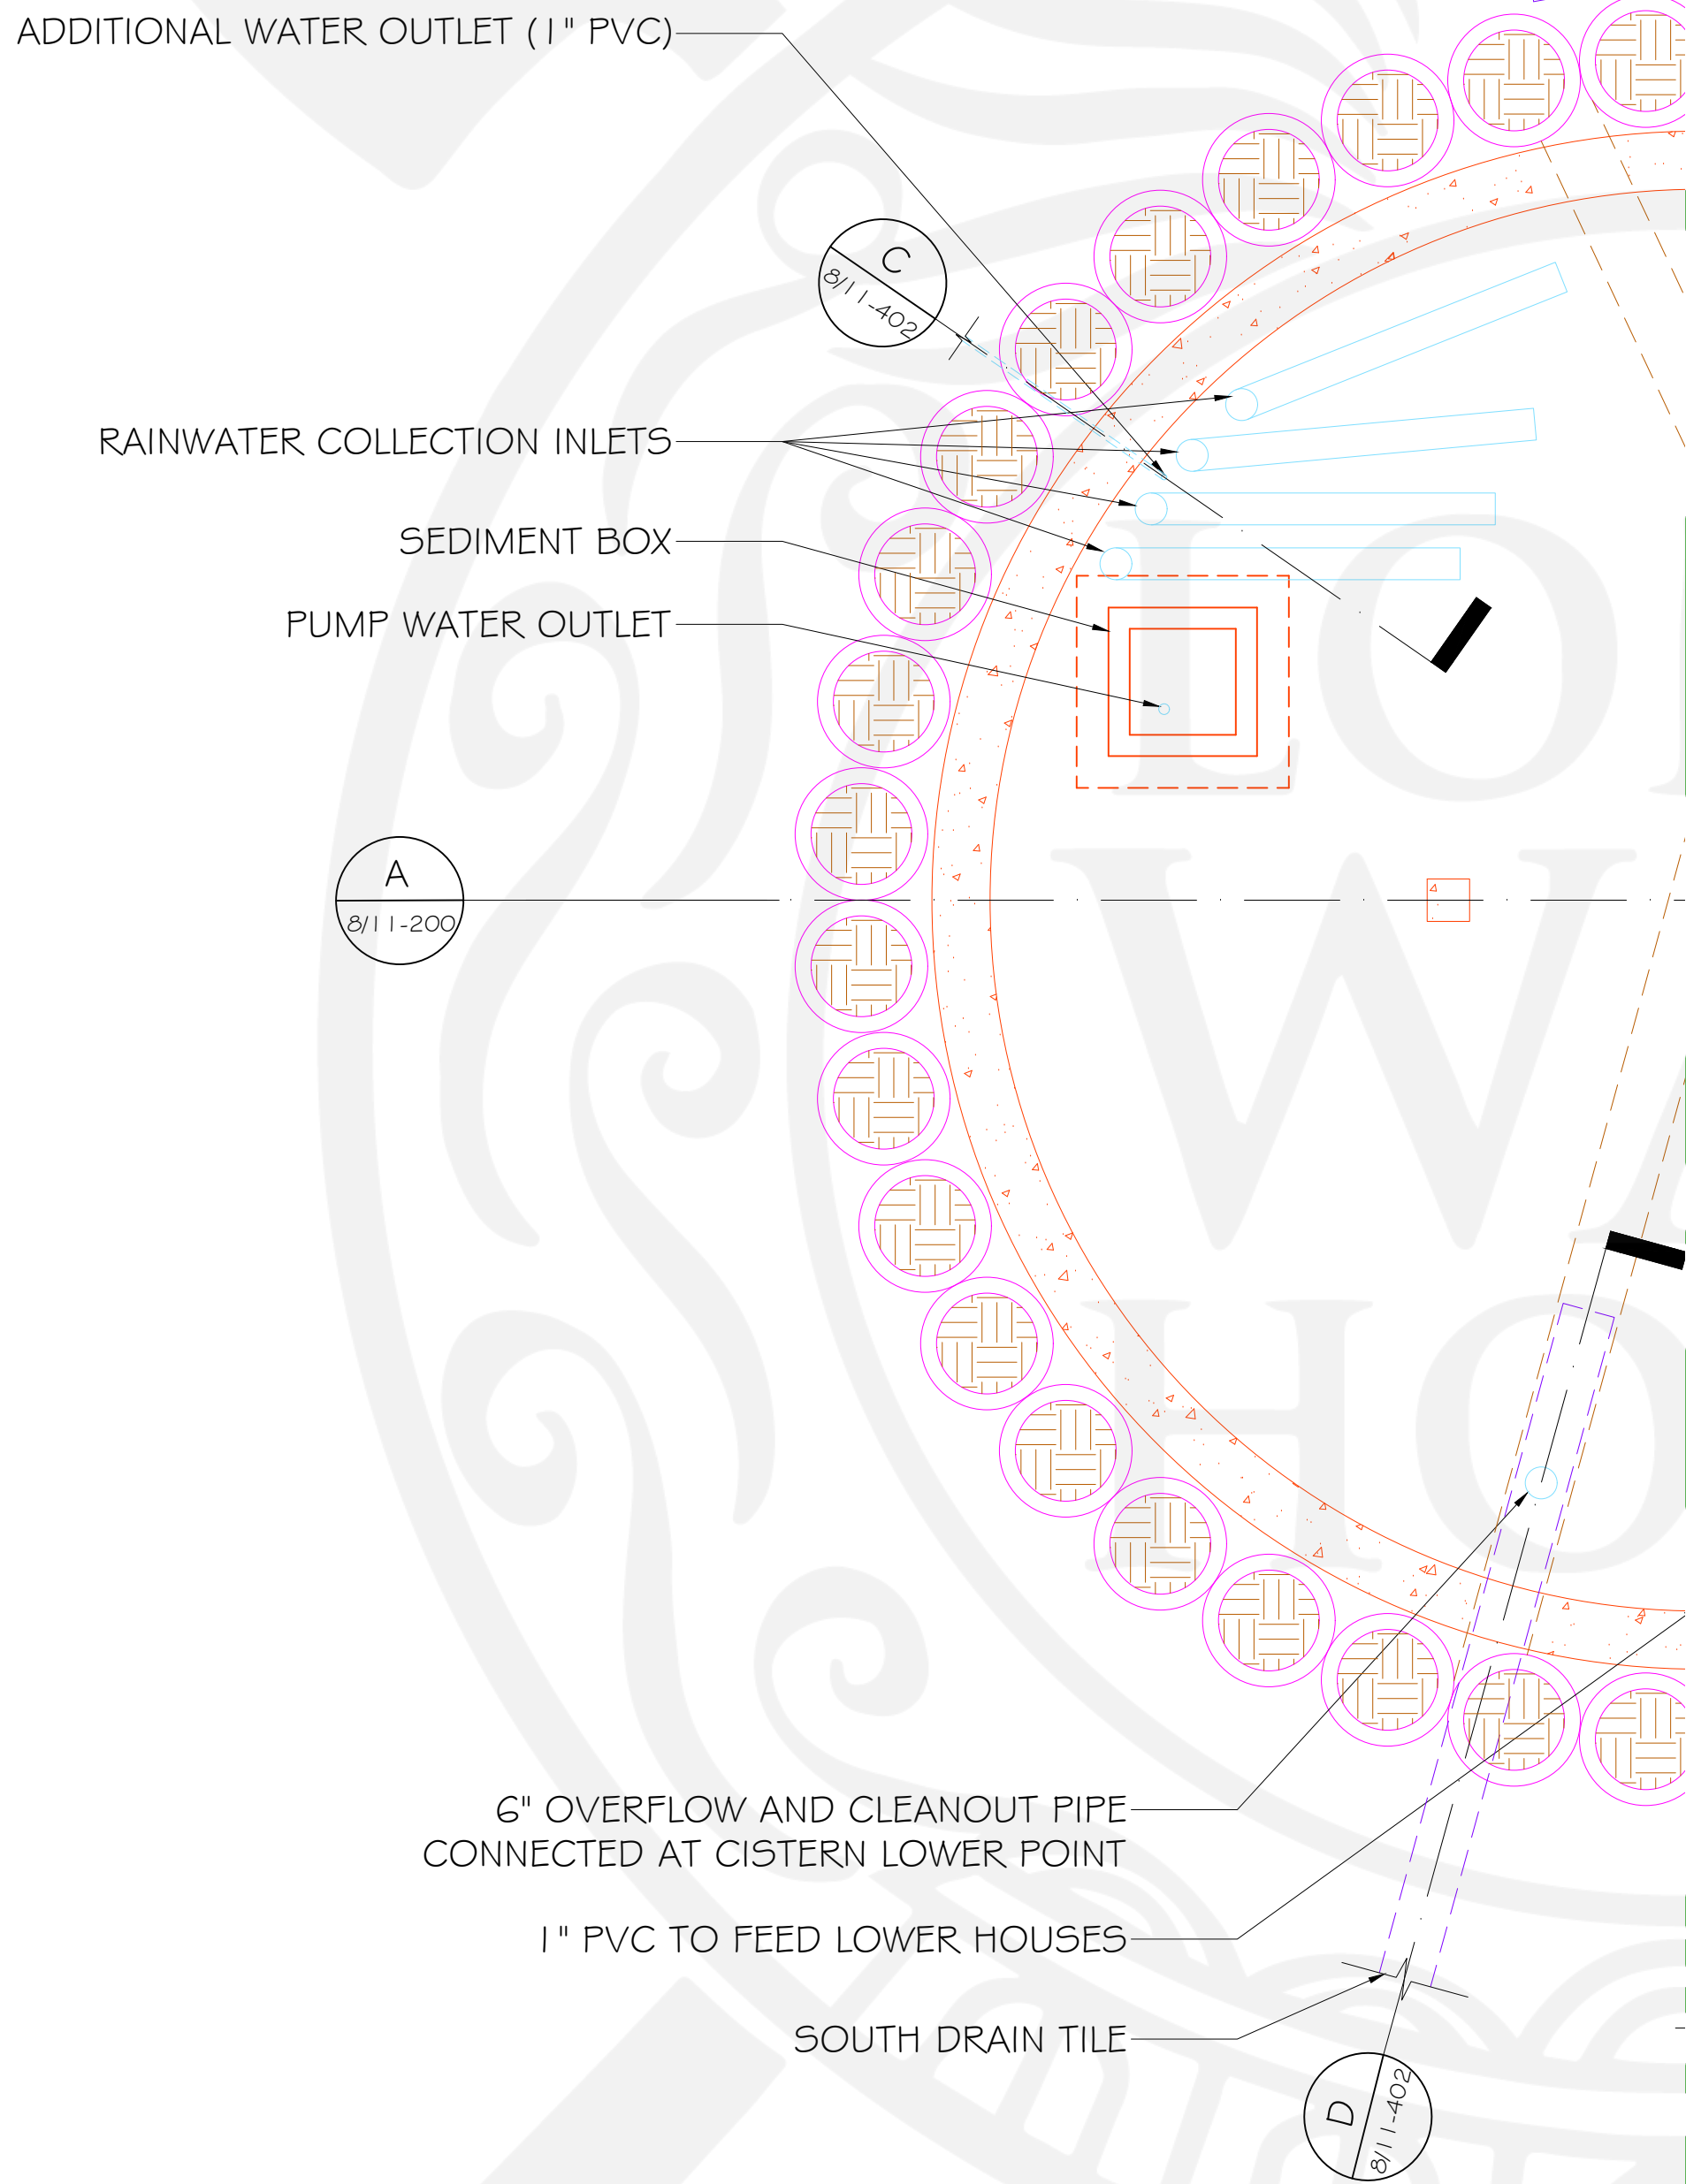

1 LOW LEVEL CISTERN PLAN  
3/8"= 1'-0"

NOTES:

1. THIS DRAWING IS A CAD DRAWING AND SHOULD NOT BE ALTERED MANUALLY.
2. THIS DRAWING MUST NOT BE USED FOR CONSTRUCTION UNLESS APPROVED OTHERWISE.
3. ALL DRAWINGS SHALL BE READ IN CONJUNCTION WITH ALL OTHER CONSULTANTS DRAWINGS AND SPECIFICATIONS.
4. THIS DOCUMENT MAY ONLY BE USED BY LONG WAY HOME'S CLIENT (AND ANY OTHER PERSON WHO LWH HAS GIVEN PERMISSION TO USE THIS DOCUMENT) FOR THE PURPOSE FOR WHICH IT WAS PREPARED AND MUST NOT BE USED BY ANY OTHER PERSON OR FOR ANY OTHER PURPOSE.
5. THIS DRAWING IS PROTECTED BY INTERNATIONAL COPYRIGHT LAW.

MATERIALS KEY:	
	CONCRETE
	TILE
	DRAIN TILE
	PIPES
	EARTH
	GRAVEL

CUT AT 4' ABOVE TOP OF SLAB.

LONG WAY HOME  
SAN JUAN COMALAPA, GUATEMALA



PROJECT:

HERO SCHOOL



HERO  
SCHOOL

BUILDING:

42,500 GALLON  
CISTERN +  
DOME LIBRARY

NO:

8/11

REVISIONS:

NO.	DATE	DESC	DRAWN BY
1	05/03/2015		M.F.
2	06/05/2021	AS BUILT	S.M.

DRAWN BY:

GERMAIN HOT

DATE:

06 MAY 2021

SHEET TITLE:

LOWER LEVEL  
CISTERN PLAN

SCALE:

3/8"= 1'-0"

SHEET SIZE:


A1

SHEET NO.


8/11-102



GROUND FLOOR INTERIOR AREA: 580 SQ FT  
LOWER LEVEL INTERIOR AREA: 380 SQ FT  
COVERED PATIO AREA: 190 SQ FT  
TOTAL AREA: 1,150 SQ FT

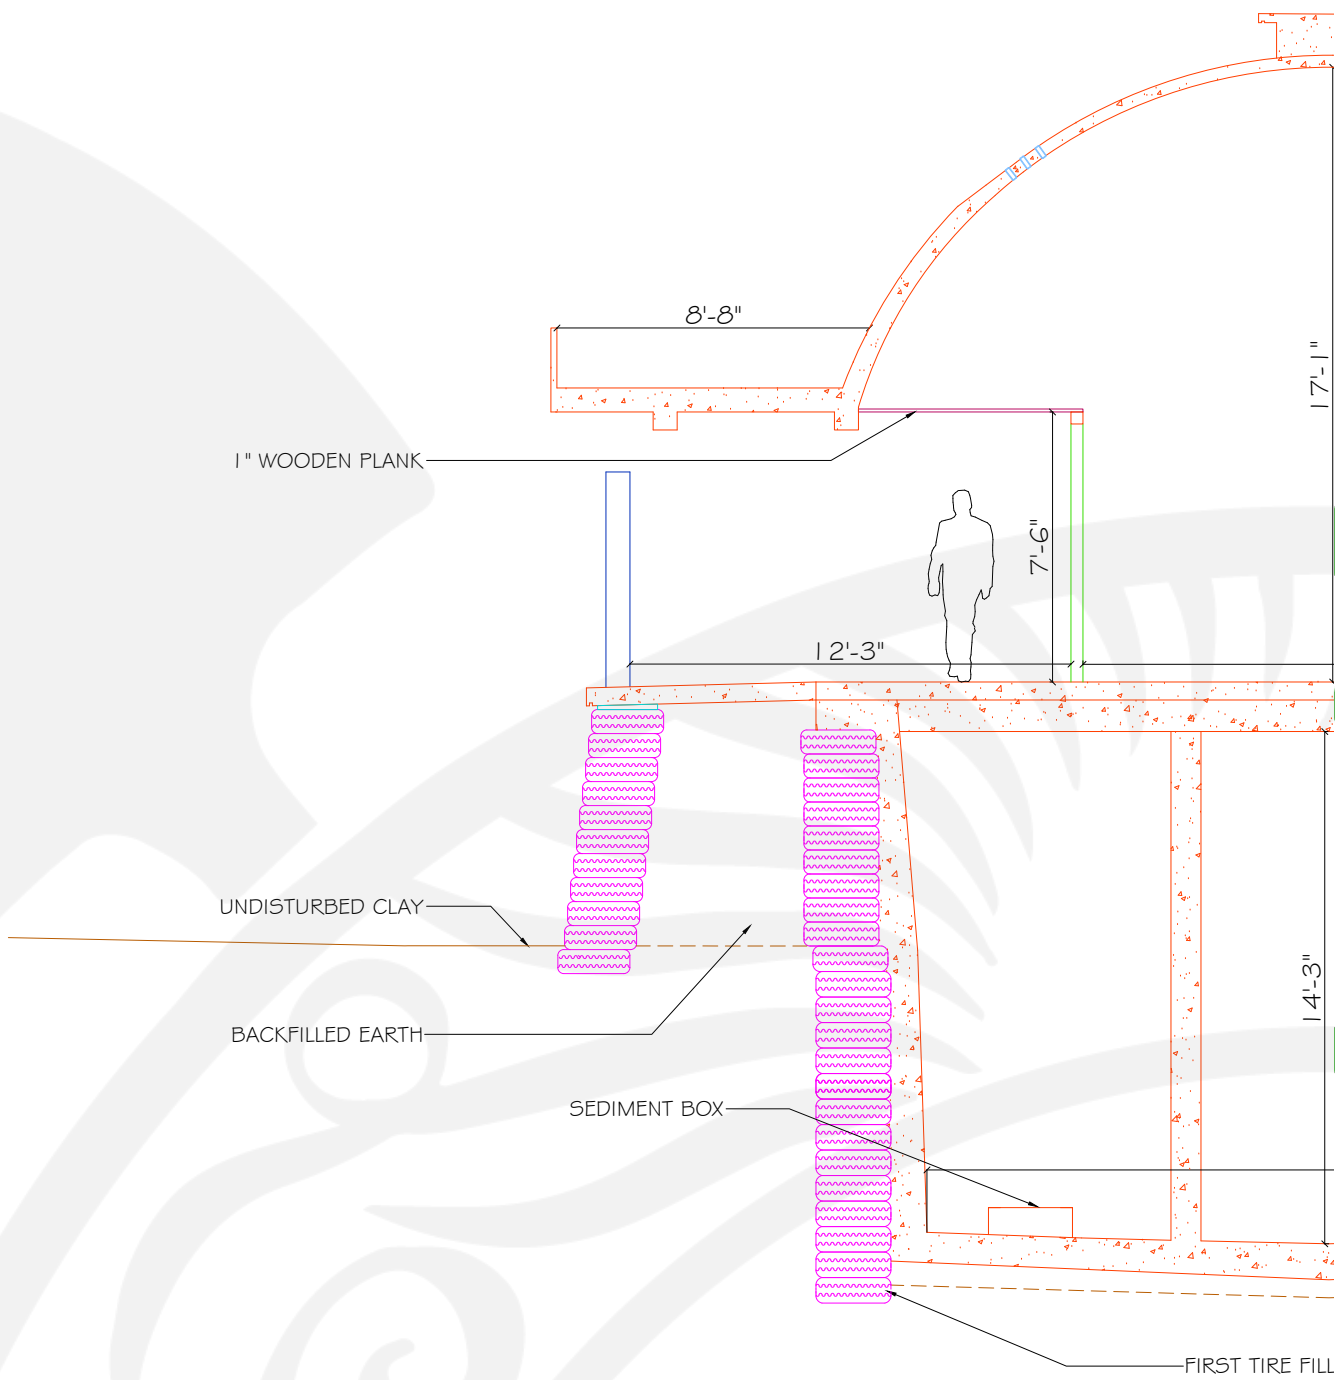

**A** SECTION A  
3/16" = 1' - 0"

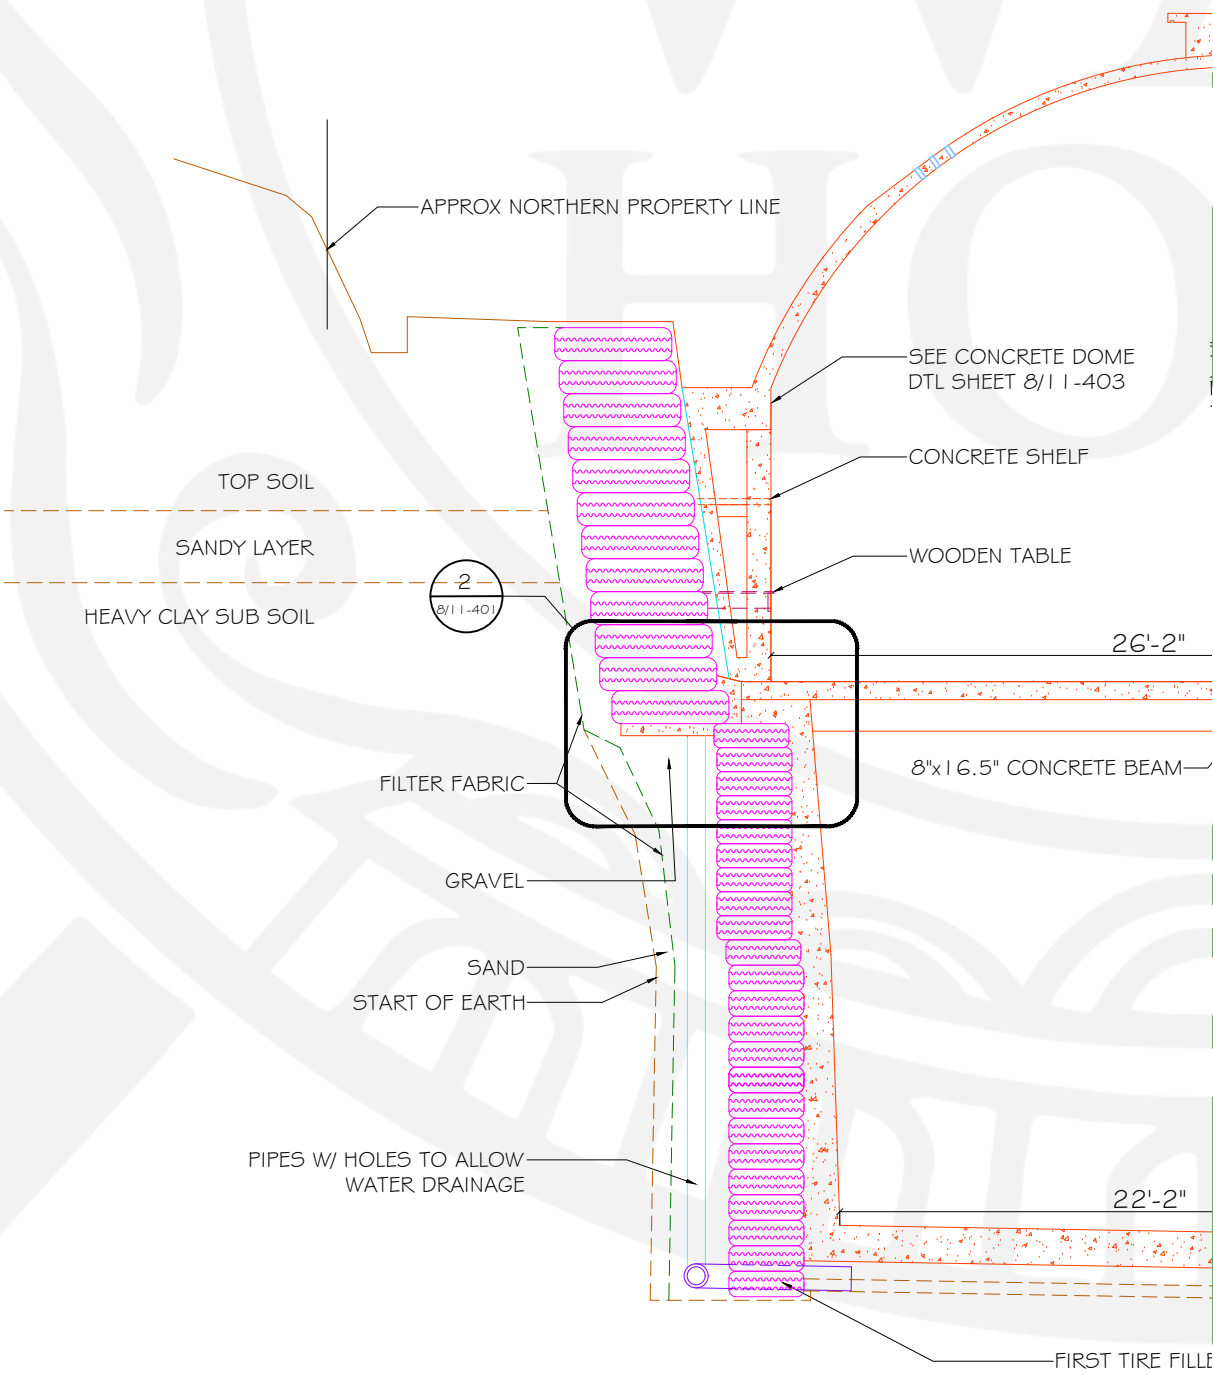

**B** SECTION B  
3/16" = 1' - 0"

NOTES:

1. THIS DRAWING IS A CAD DRAWING AND SHOULD NOT BE ALTERED MANUALLY.
2. THIS DRAWING MUST NOT BE USED FOR CONSTRUCTION UNLESS APPROVED OTHERWISE.
3. ALL DRAWINGS SHALL BE READ IN CONJUNCTION WITH ALL OTHER CONSULTANTS DRAWINGS AND SPECIFICATIONS.
4. THIS DOCUMENT MAY ONLY BE USED BY LONG WAY HOME'S CLIENT (AND ANY OTHER PERSON WHO LWH HAS GIVEN PERMISSION TO USE THIS DOCUMENT) FOR THE PURPOSE FOR WHICH IT WAS PREPARED AND MUST NOT BE USED BY ANY OTHER PERSON OR FOR ANY OTHER PURPOSE.
5. THIS DRAWING IS PROTECTED BY INTERNATIONAL COPYRIGHT LAW.

MATERIALS KEY:

CONCRETE	EARTH
TIRE	GRAVEL
TIMBER	PIPES
STEEL REBAR	DRAIN TILE
GLASS	OTHER
COB + PLASTER FINISHES	

WALL TYPES KEY:

WALL TYPE A: RAMMED EARTH TIRES
WALL TYPE B: RAMMED EARTH TIRES
WALL TYPE C: GLASS BOTTLES + MORTAR
WALL TYPE D: ECOBRICKS + MORTAR

LONG WAY HOME  
SAN JUAN COMALAPA, GUATEMALA



PROJECT:  
**HERO SCHOOL**

BUILDING:  
42,500 GALLON  
CISTERN +  
DOME LIBRARY

REVISIONS:

NO.	DATE	DESC	DRAWN BY
1	05/03/2015		M.F.
2	06/05/2021	AS BUILT	S.M.

DRAWN BY:  
GERMAIN HOT

DATE:  
06 MAY 2021



SHEET TITLE:  
SECTIONS

SCALE:  
3/16" = 1' - 0"

SHEET SIZE:  
A1

SHEET NO.  
8/11-200



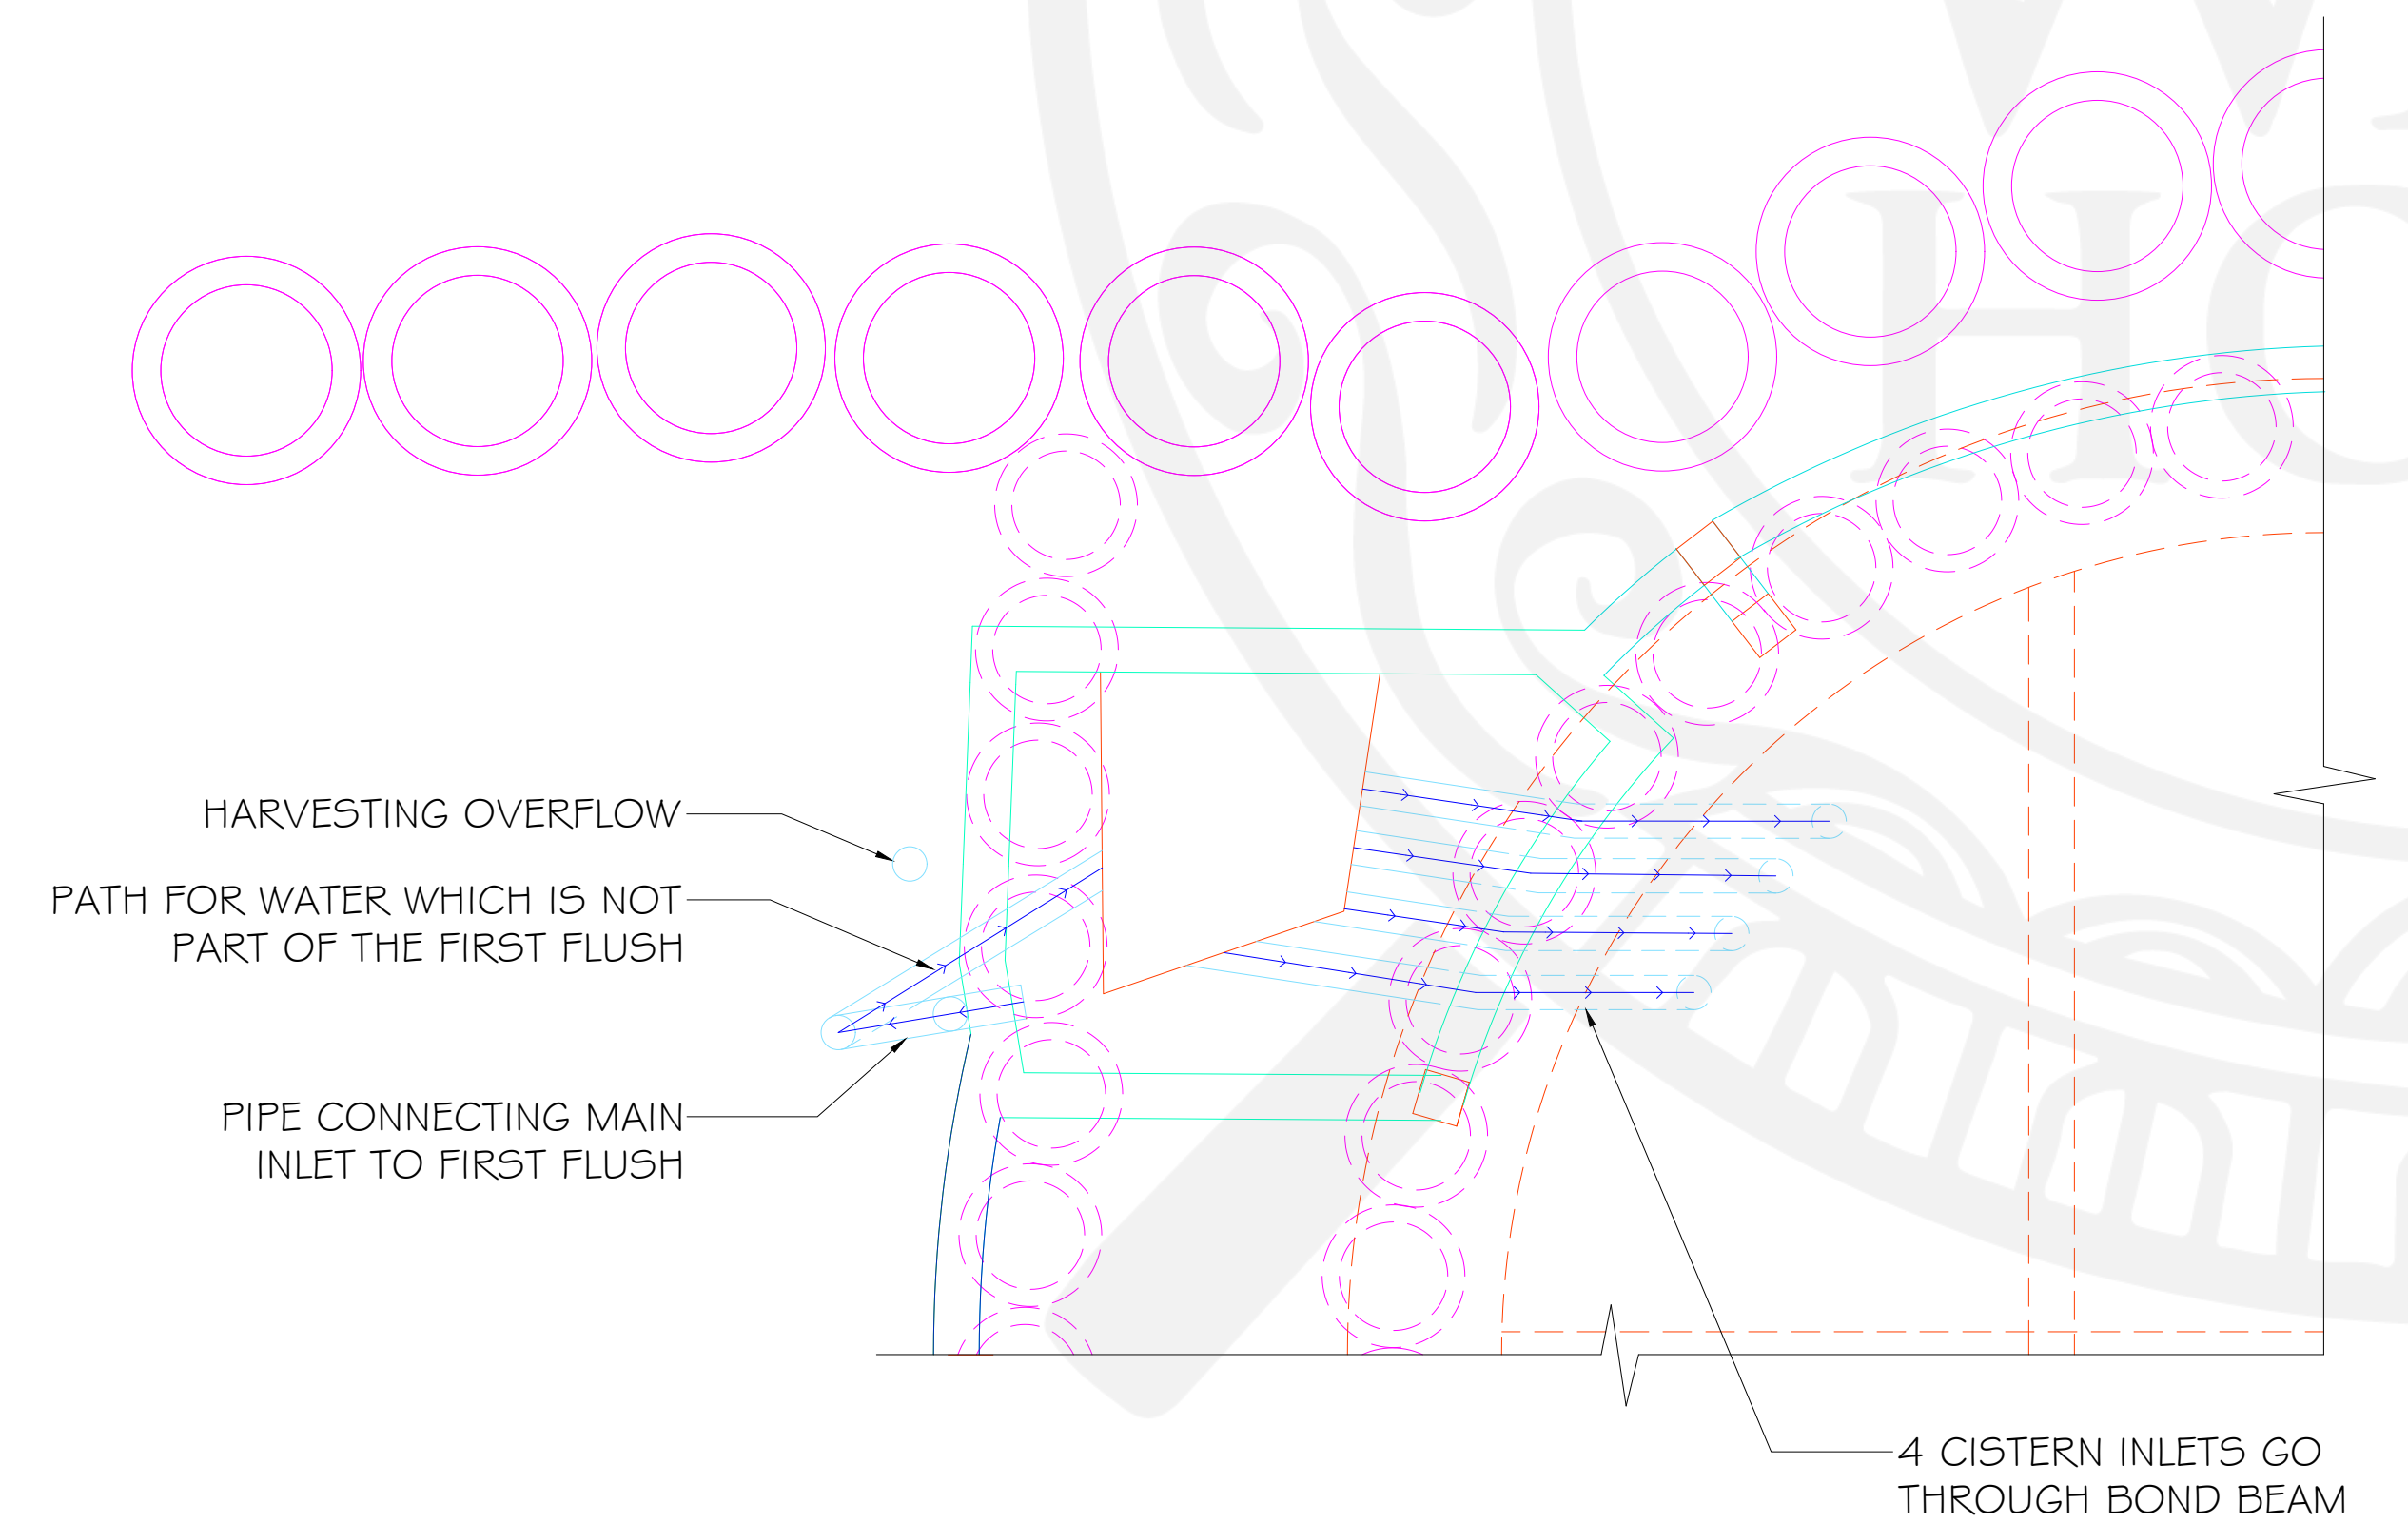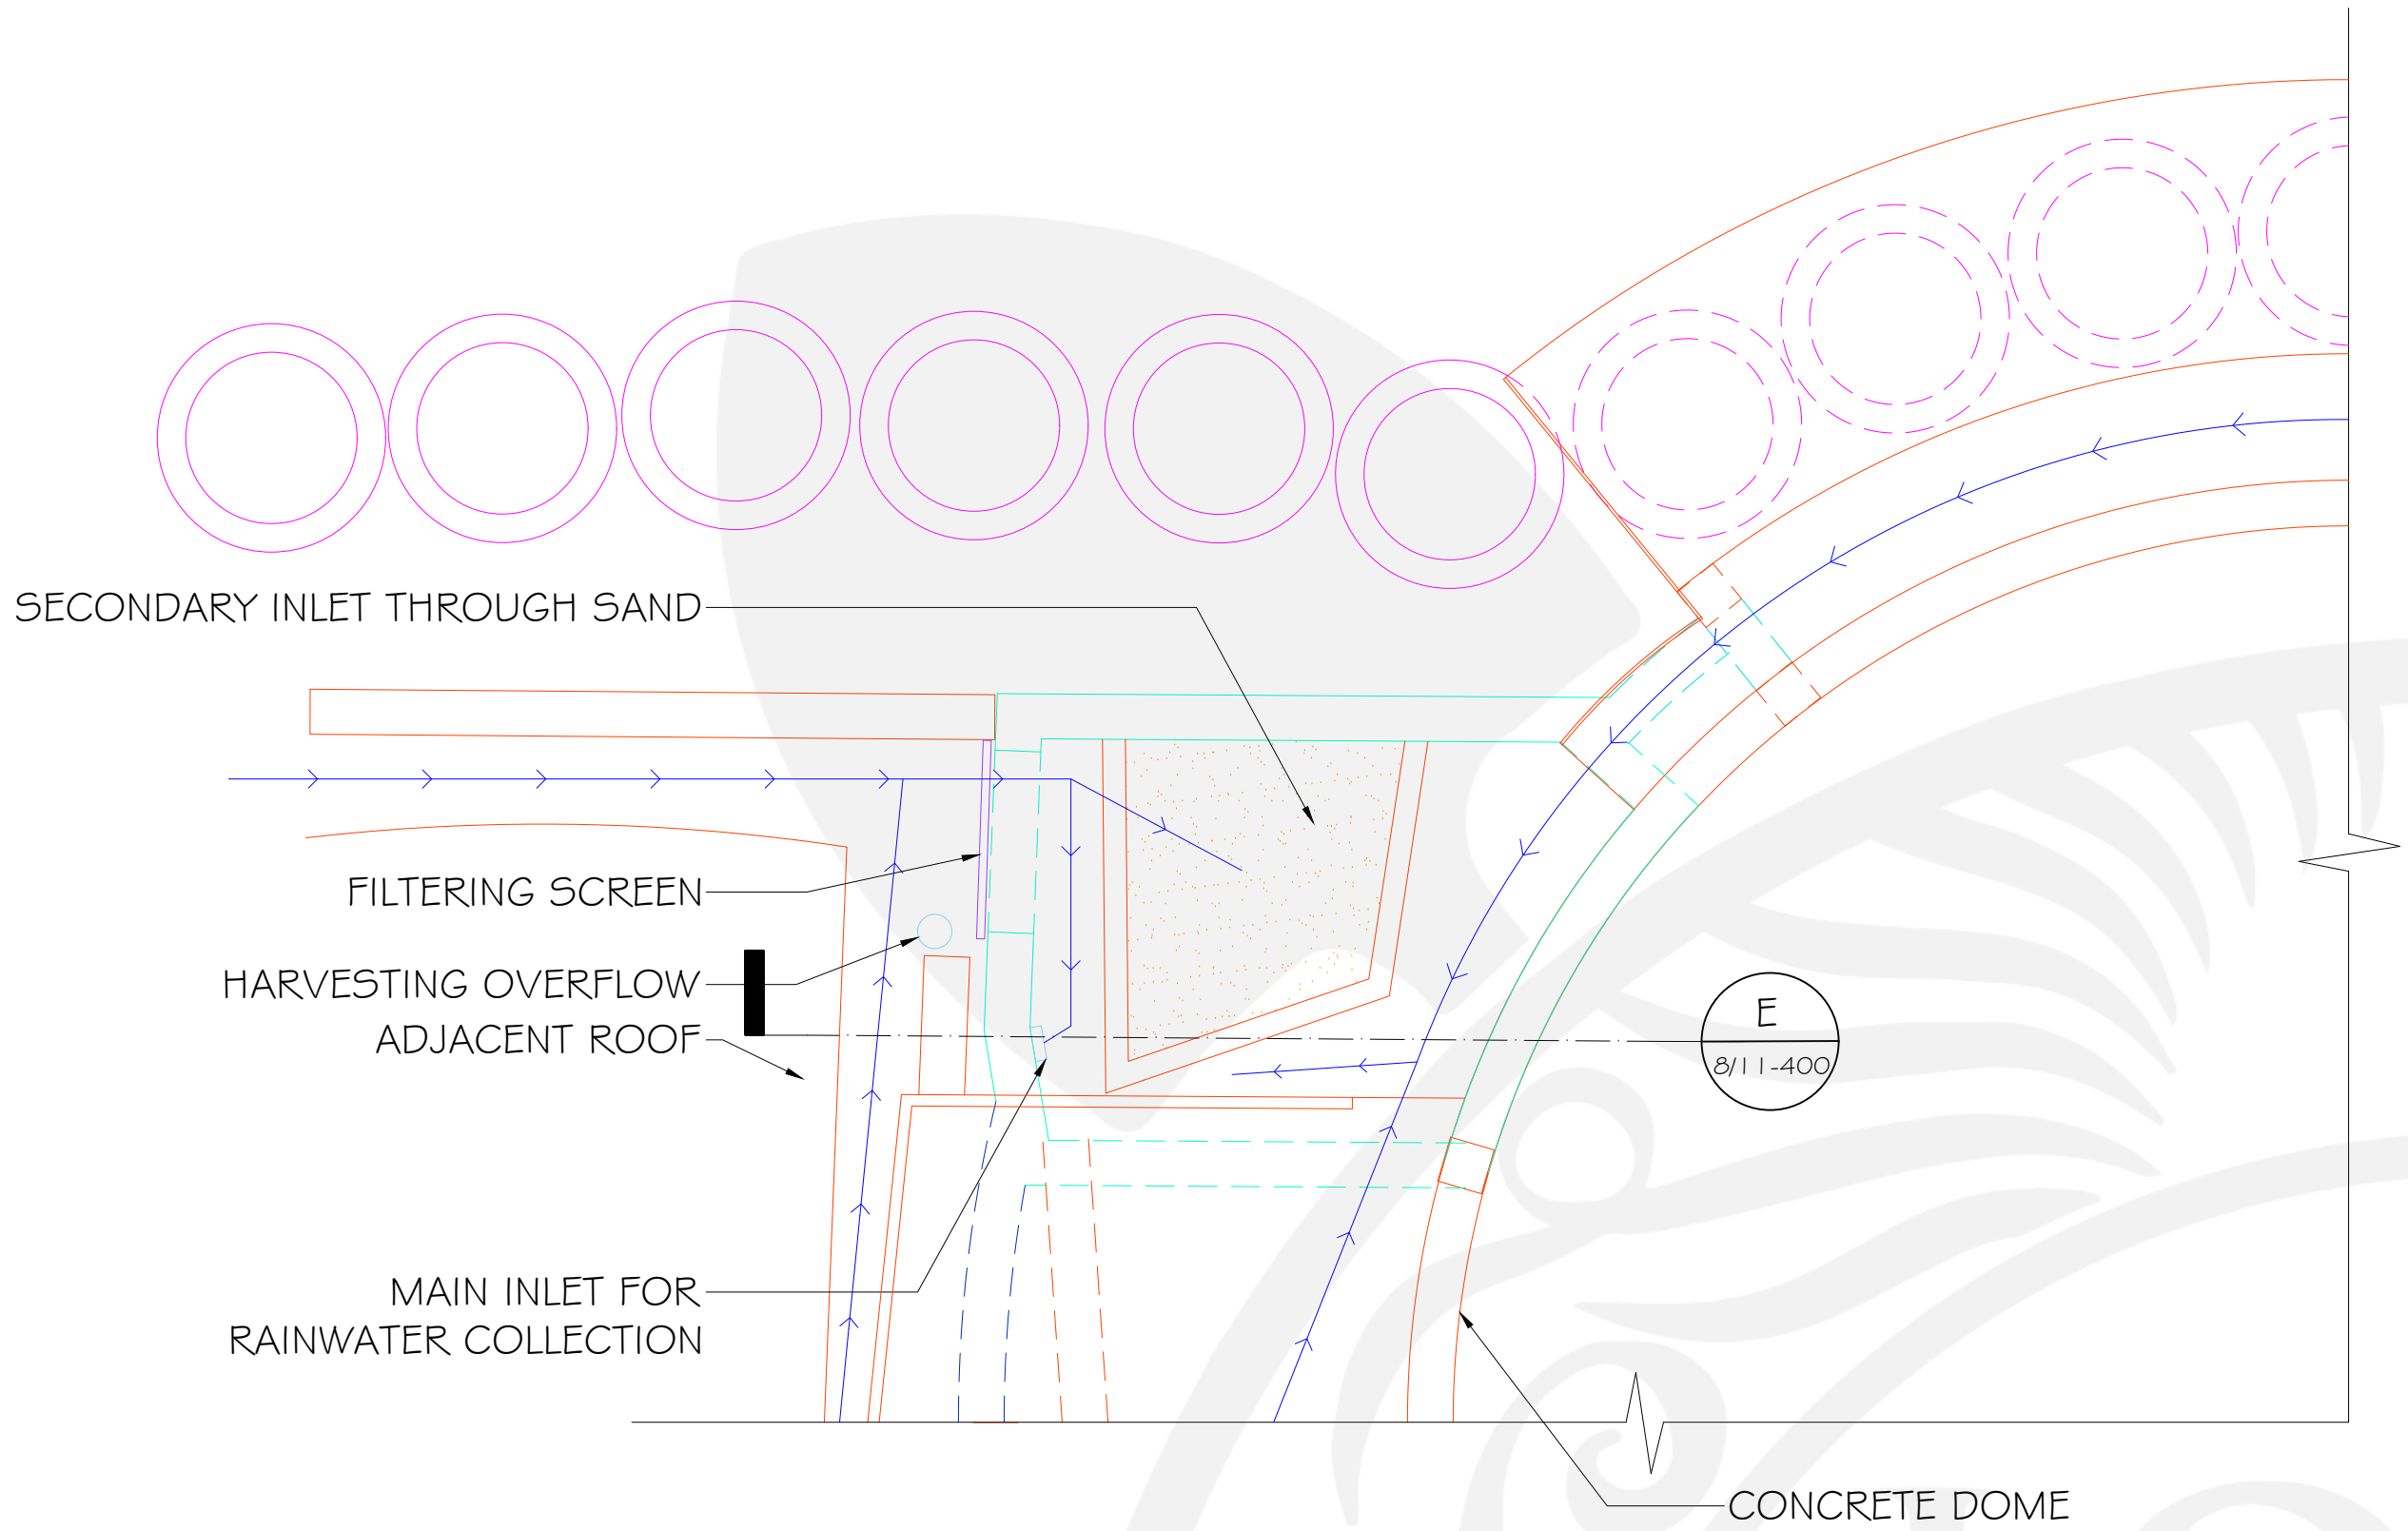

## NOTES:

1. THIS DRAWING IS A CAD DRAWING AND SHOULD NOT BE ALTERED MANUALLY.
2. THIS DRAWING MUST NOT BE USED FOR CONSTRUCTION UNLESS APPROVED OTHERWISE.
3. ALL DRAWINGS SHALL BE READ IN CONJUNCTION WITH ALL OTHER CONSULTANTS DRAWINGS AND SPECIFICATIONS.
4. THIS DOCUMENT MAY ONLY BE USED BY LONG WAY HOME'S CLIENT (AND ANY OTHER PERSON WHO LWH HAS GIVEN PERMISSION TO USE THIS DOCUMENT) FOR THE PURPOSE FOR WHICH IT WAS PREPARED AND MUST NOT BE USED BY ANY OTHER PERSON OR FOR ANY OTHER PURPOSE.
5. THIS DRAWING IS PROTECTED BY INTERNATIONAL COPYRIGHT LAW.

### MATERIALS KEY:

	CONCRETE
	TIRE
	COB
	SAND
	PIPES
	DRAIN TILE
	PLASTIC
	TIERRA
	DENOTES DRAINAGE FLOW OF RAINWATER

### WALL TYPES KEY:

	WALL TYPE C: GLASS BOTTLES + MORTAR
	WALL TYPE F: ECOBRICKS + MORTAR

LONG WAY HOME  
SAN JUAN COMALAPA, GUATEMALA



WWW.LWHOME.ORG  
INFO@LWHOME.ORG

PROJECT:

HERO SCHOOL



BUILDING:

42,500 GALLON  
CISTERN +  
DOME LIBRARY

NO:

8/11

### REVISIONS:

NO.	DATE	DESC	DRAWN BY
1	05/03/2015		M.F.
2	06/05/2021	AS BUILT	S.M.

DRAWN BY:

GERMAIN HOT

DATE:

06 MAY 2021

SHEET TITLE:

RAINWATER  
COLLECTION DETAILS

SCALE:

3/8" = 1' - 0"

SHEET SIZE:


A1

SHEET NO.

8/11-400

PAGE 5  
OF 11




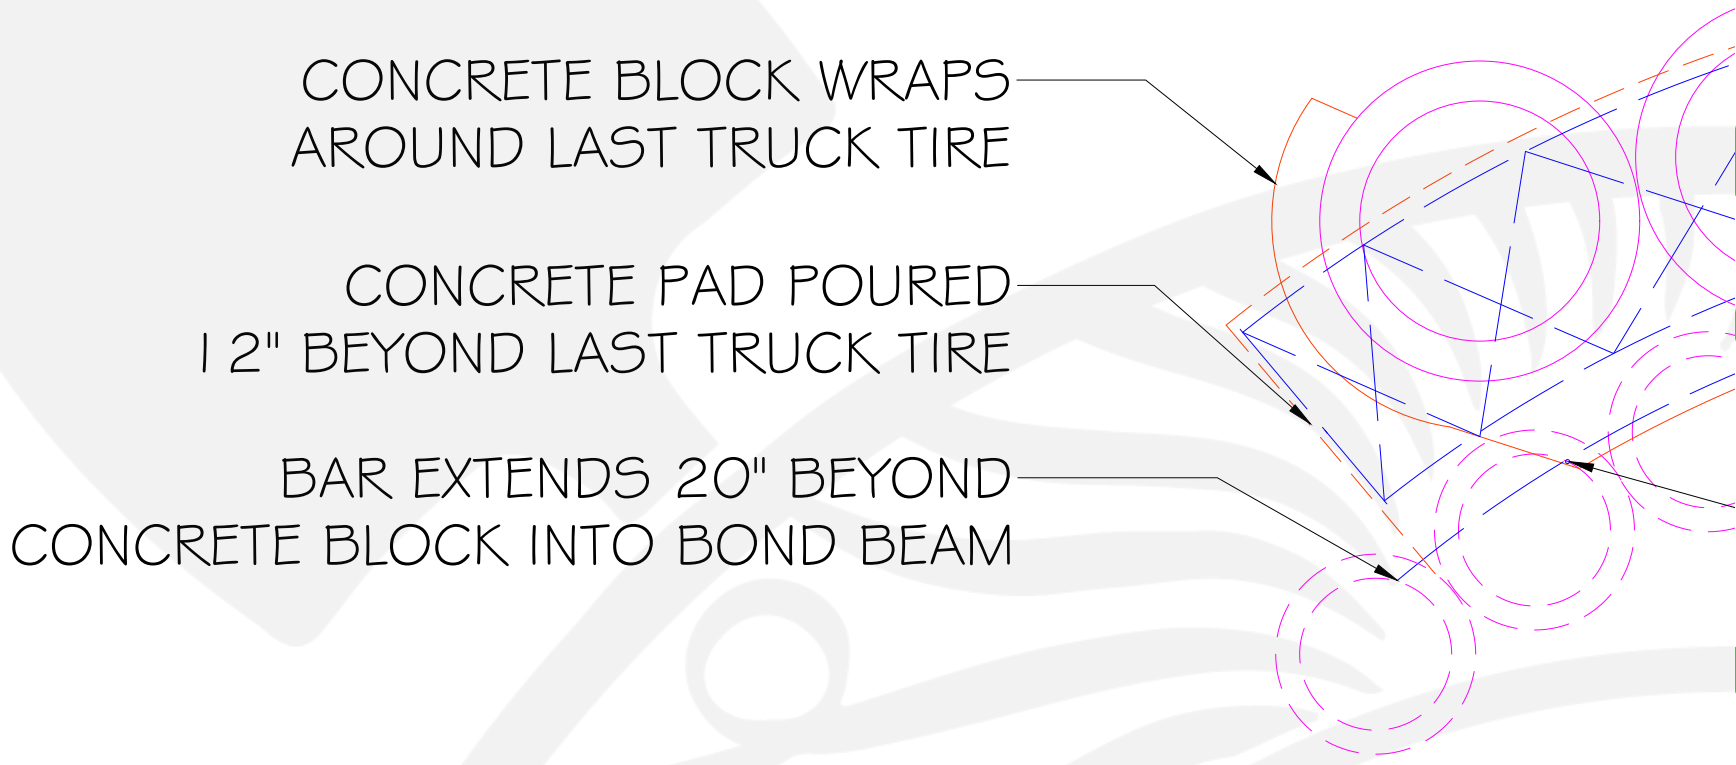

1  
8/11-100

TYPICAL END OF TRUCK TIRE WALL FOUNDATION DETAIL

1" = 1/2'-0"

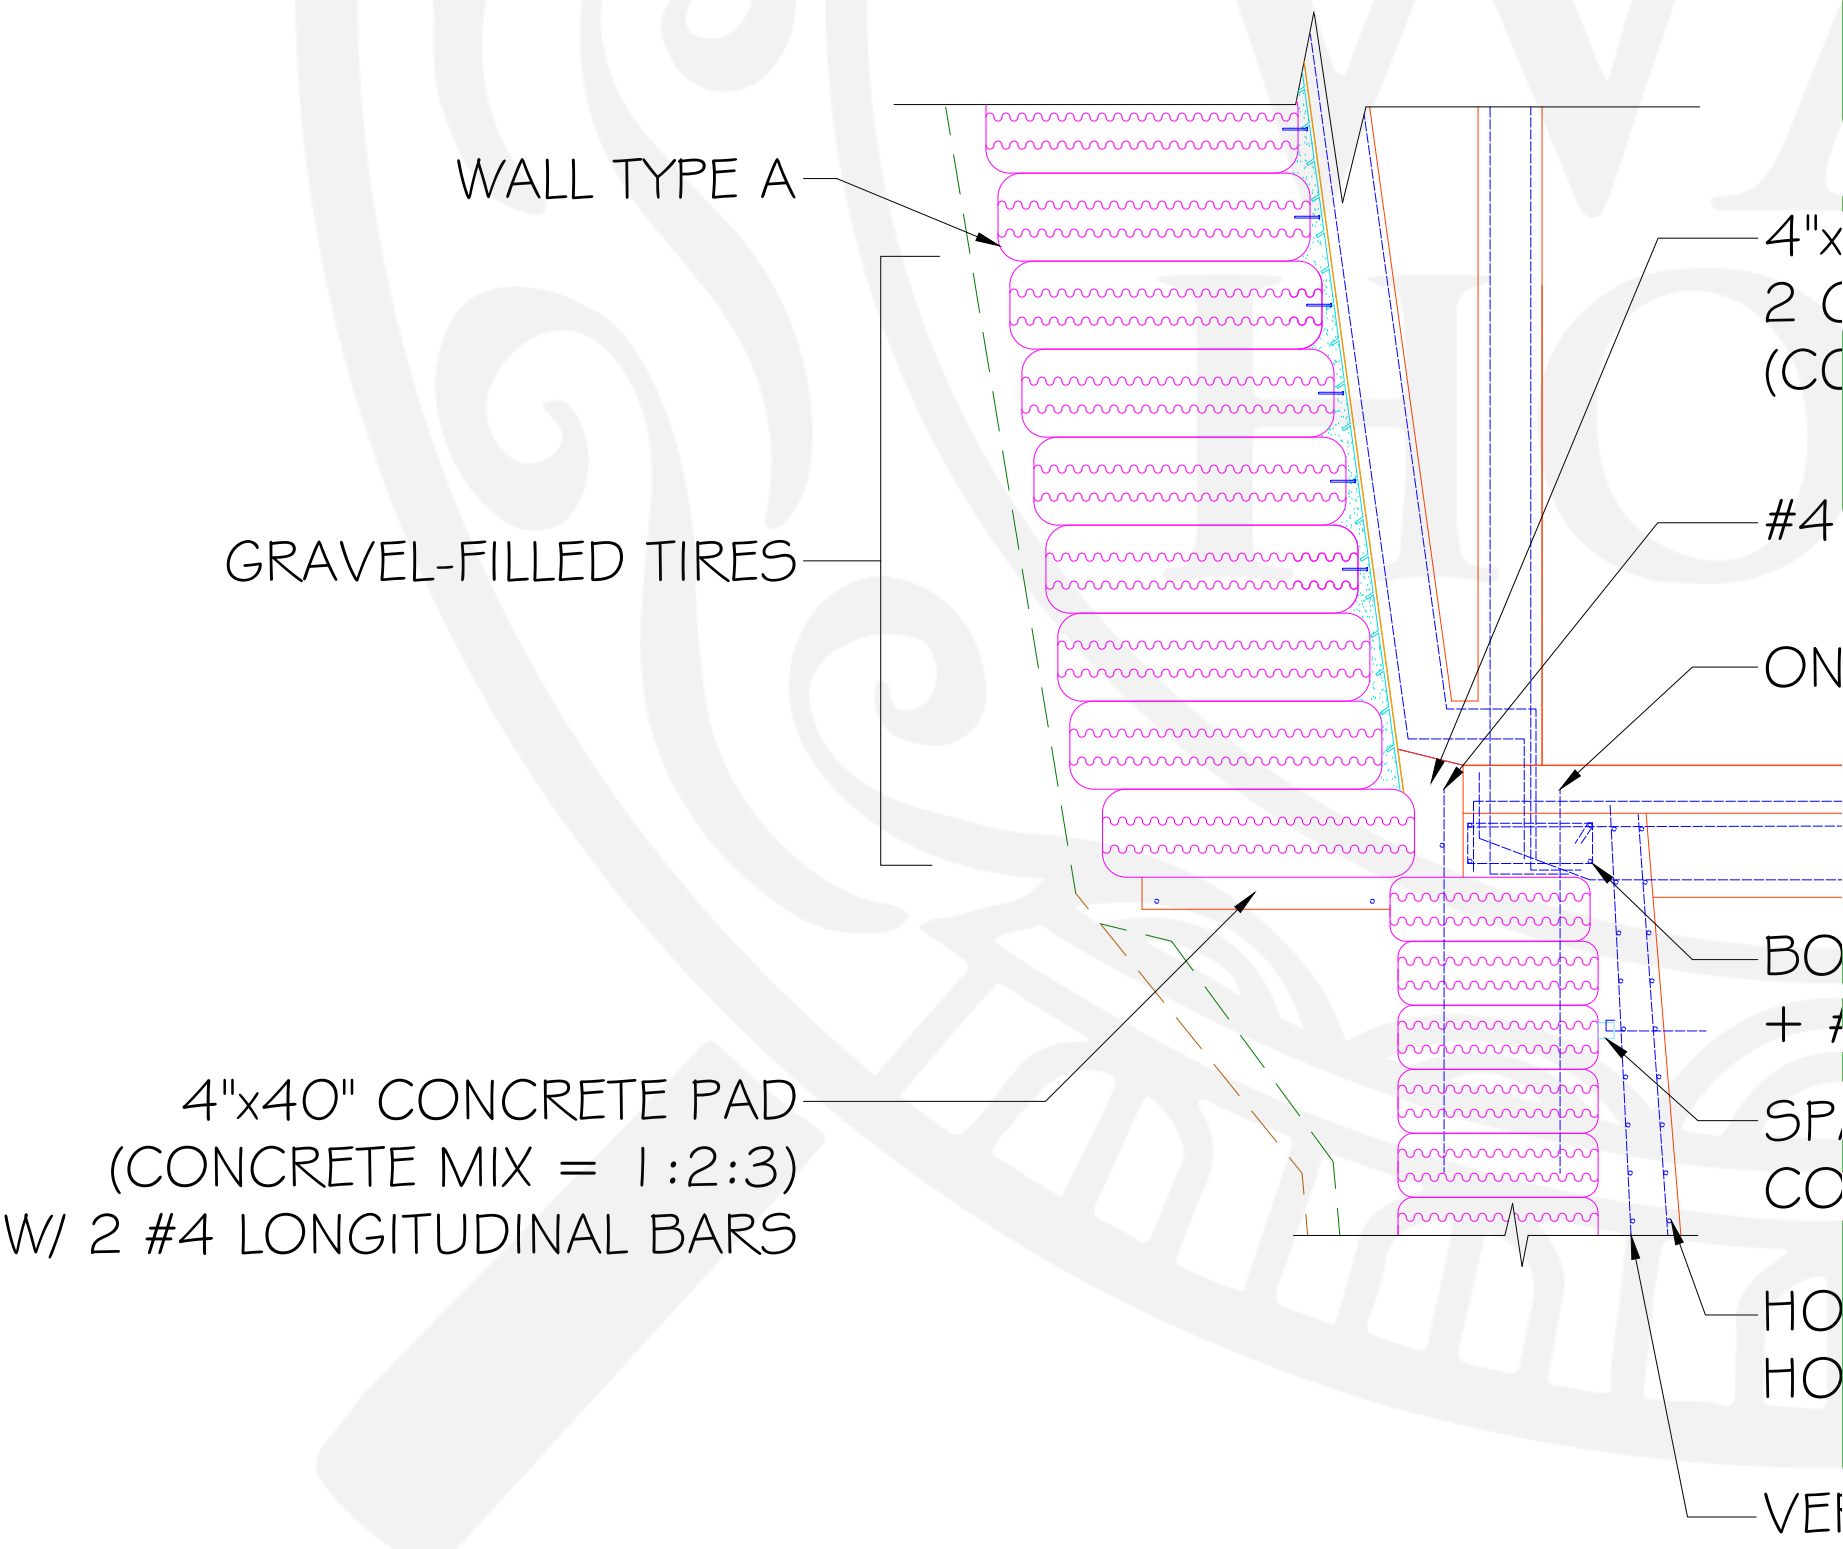

2  
8/11-200

TYPICAL TRUCK TIRE WALL FOUNDATION DETAIL

1" = 1/2'-0"

NOTES:

1. THIS DRAWING IS A CAD DRAWING AND SHOULD NOT BE ALTERED MANUALLY.
2. THIS DRAWING MUST NOT BE USED FOR CONSTRUCTION UNLESS APPROVED OTHERWISE.
3. ALL DRAWINGS SHALL BE READ IN CONJUNCTION WITH ALL OTHER CONSULTANTS DRAWINGS AND SPECIFICATIONS.
4. THIS DOCUMENT MAY ONLY BE USED BY LONG WAY HOME'S CLIENT (AND ANY OTHER PERSON WHO LWH HAS GIVEN PERMISSION TO USE THIS DOCUMENT) FOR THE PURPOSE FOR WHICH IT WAS PREPARED AND MUST NOT BE USED BY ANY OTHER PERSON OR FOR ANY OTHER PURPOSE.
5. THIS DRAWING IS PROTECTED BY INTERNATIONAL COPYRIGHT LAW.

MATERIALS KEY:

- CONCRETE
- TIRE
- COB
- STEEL REINFORCEMENT
- SAND
- EARTH
- GRAVEL
- PIPES
- DRAIN TILE

BOND BEAM + LIBRARY SLAB ARE NOT SHOWN ON DETAIL 1 FOR CLARITY PURPOSES.

REINFORCEMENT NOTES:

ALL BARS ARE #4 BARS (UNLESS NOTED OTHERWISE)

LINKS FOR COLUMNS + CISTERN CEILING BEAMS ARE NOT SHOWN FOR CLARITY

ALL LINKS ARE #2 BARS @8' C/C

LONG WAY HOME  
SAN JUAN COMALAPA, GUATEMALA



WWW.LWHOME.ORG  
INFO@LWHOME.ORG

PROJECT:

HERO SCHOOL



BUILDING:

42,500 GALLON  
CISTERN +  
DOME LIBRARY

NO:

8/11

REVISIONS:

NO.	DATE	DESC	DRAWN BY
1	05/03/2015		M.F.
2	06/05/2021	AS BUILT	S.M.

DRAWN BY:

GERMAIN HOT

DATE:

06 MAY 2021

SHEET TITLE:

TRUCK TIRE WALL  
FOUNDATION DETAILS

SCALE:

3/16" = 1'-0"


SHEET SIZE:

A1

SHEET NO.

8/11-401



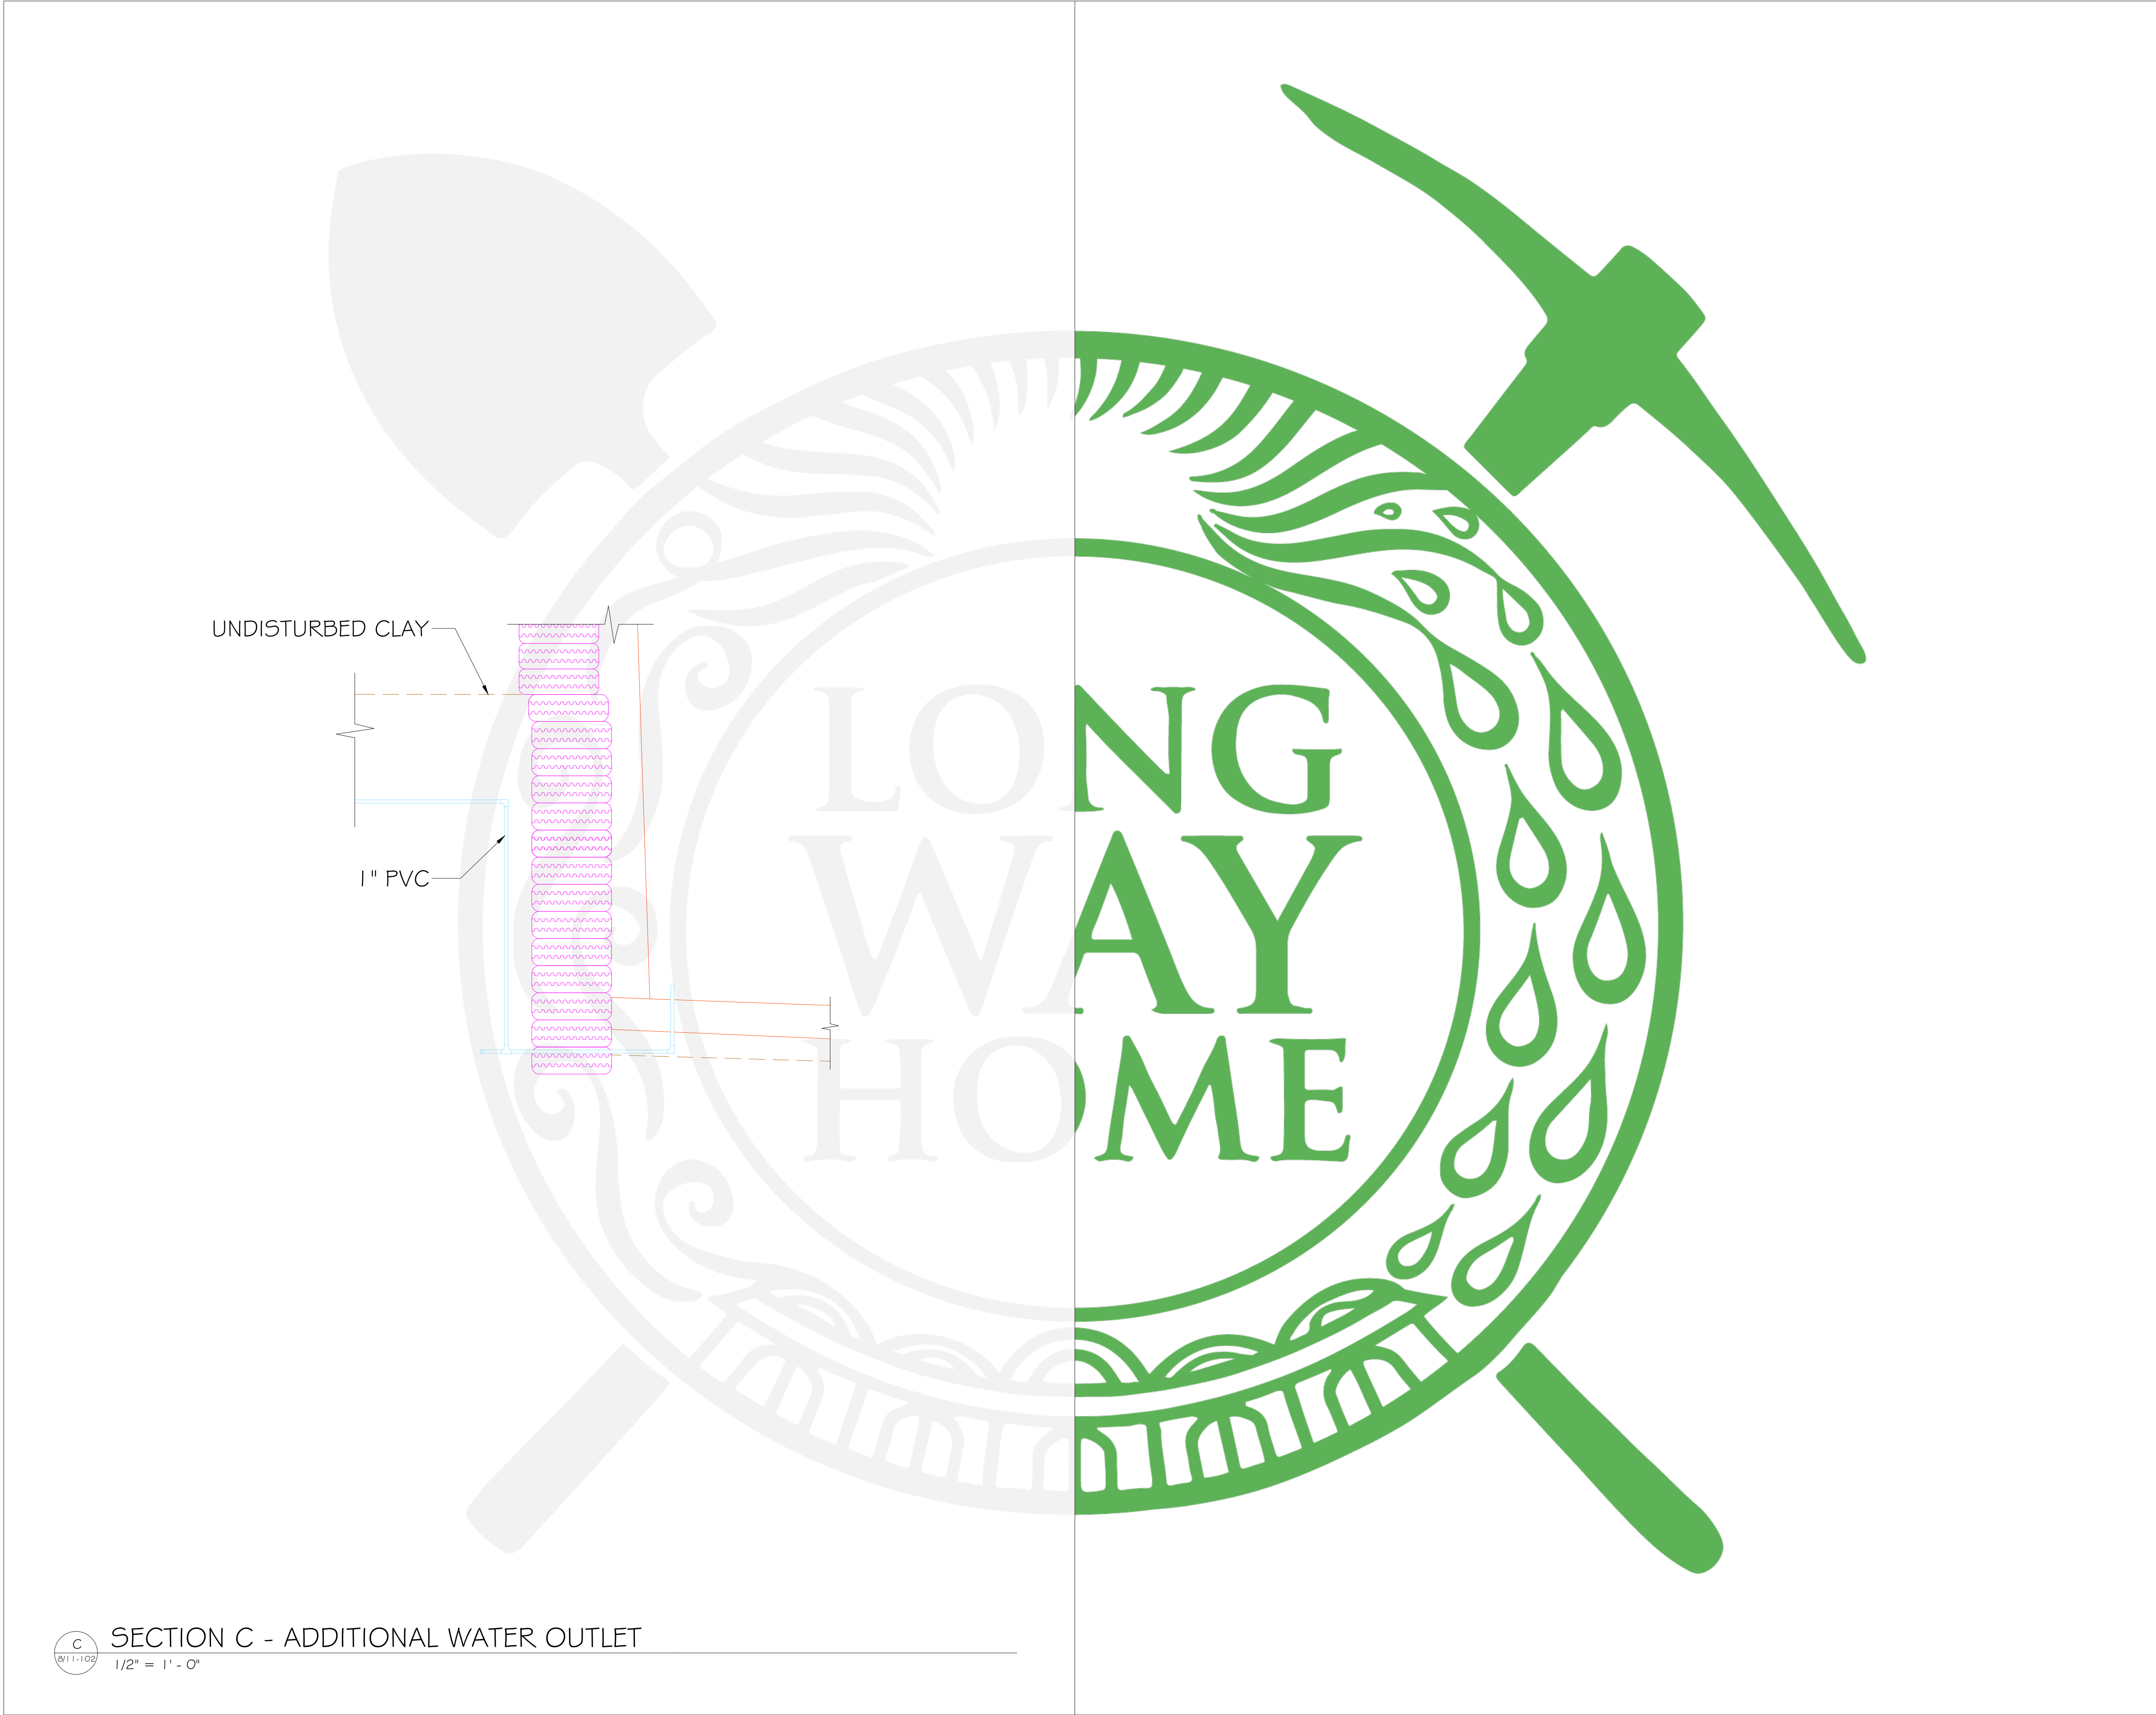

- NOTES:
1. THIS DRAWING IS A CAD DRAWING AND SHOULD NOT BE ALTERED MANUALLY.
  2. THIS DRAWING MUST NOT BE USED FOR CONSTRUCTION UNLESS APPROVED OTHERWISE.
  3. ALL DRAWINGS SHALL BE READ IN CONJUNCTION WITH ALL OTHER CONSULTANTS DRAWINGS AND SPECIFICATIONS.
  4. THIS DOCUMENT MAY ONLY BE USED BY LONG WAY HOME'S CLIENT (AND ANY OTHER PERSON WHO LWH HAS GIVEN PERMISSION TO USE THIS DOCUMENT) FOR THE PURPOSE FOR WHICH IT WAS PREPARED AND MUST NOT BE USED BY ANY OTHER PERSON OR FOR ANY OTHER PURPOSE.
  5. THIS DRAWING IS PROTECTED BY INTERNATIONAL COPYRIGHT LAW.

MATERIALS KEY:	
	CONCRETE
	TIRE
	COB
	DRAIN TILE
	PIPES
	EARTH
	GRAVEL

LONG WAY HOME  
SAN JUAN COMALAPA, GUATEMALA

WWW.LWHOME.ORG  
INFO@LWHOME.ORG

PROJECT:

HERO SCHOOL

HERO SCHOOL

BUILDING:	NO:
42,500 GALLON CISTERN + DOME LIBRARY	8/11

REVISIONS:			
NO.	DATE	DESC	DRAWN BY
1	05/03/2015		M.F.
2	06/05/2021	AS BUILT	S.M.

DRAWN BY:  
GERMAIN HOT

DATE:  
06 MAY 2021


SHEET TITLE:  
CISTERN PIPE  
DETAILS

SCALE: 1/2" = 1'-0"	SHEET SIZE: A1
------------------------	-------------------


SHEET NO.  
8/11-402

PAGE 7  
OF 11



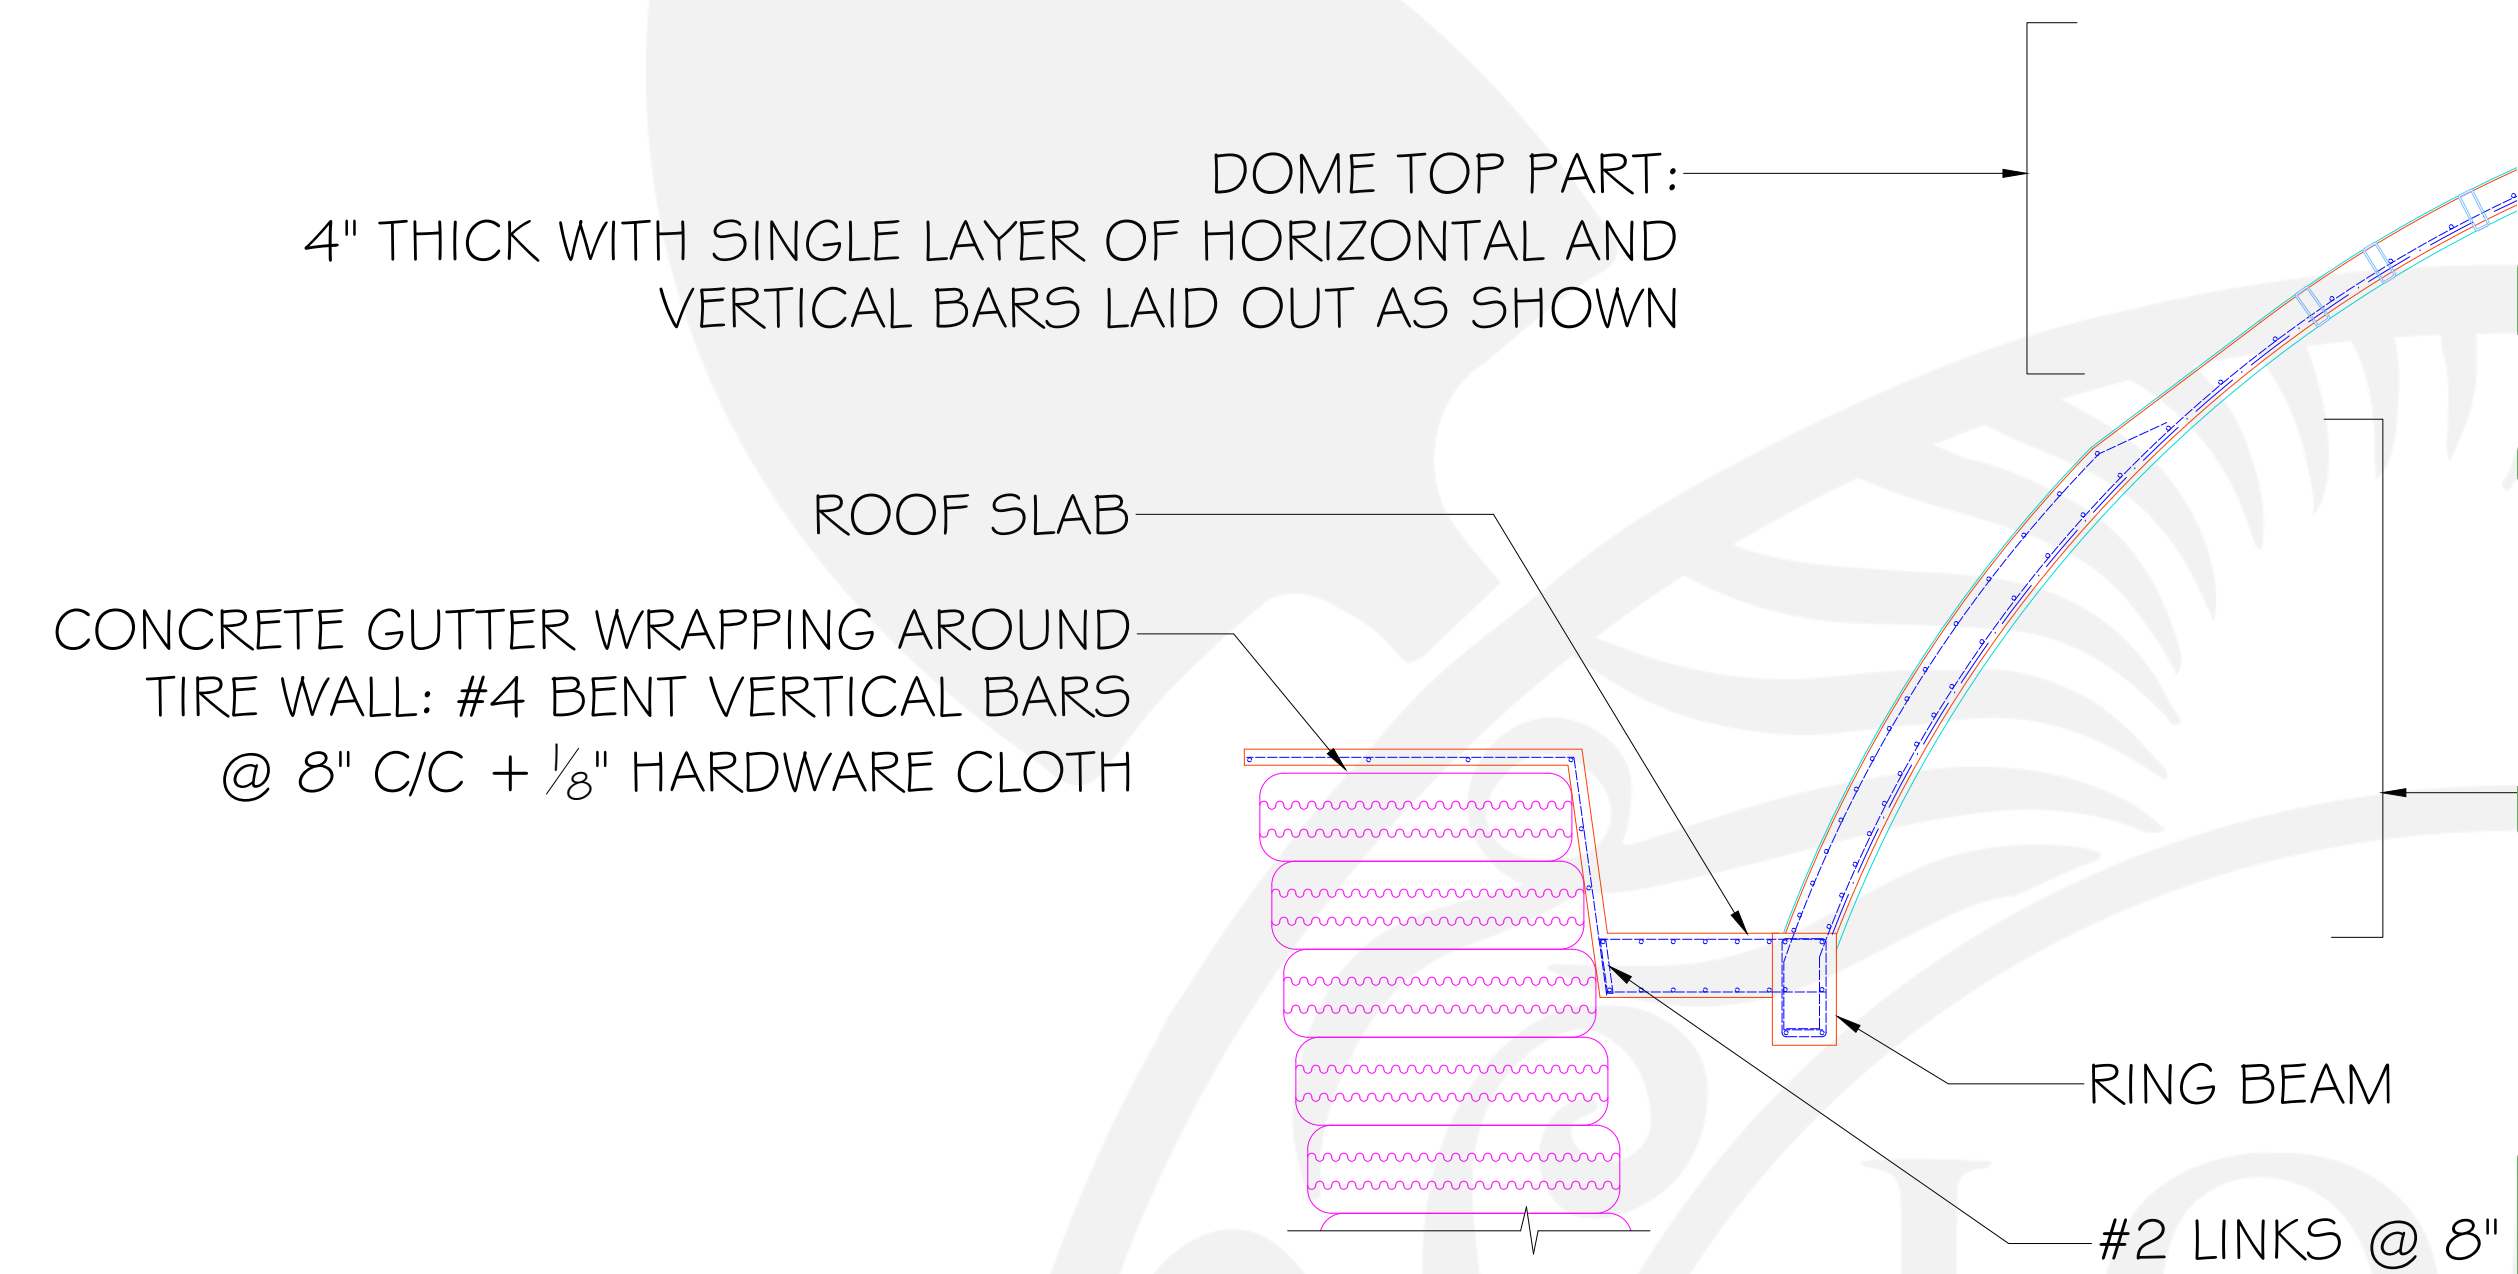

1 CONCRETE DOME W/O ROOF BEAM  
1/2" = 1' - 0"

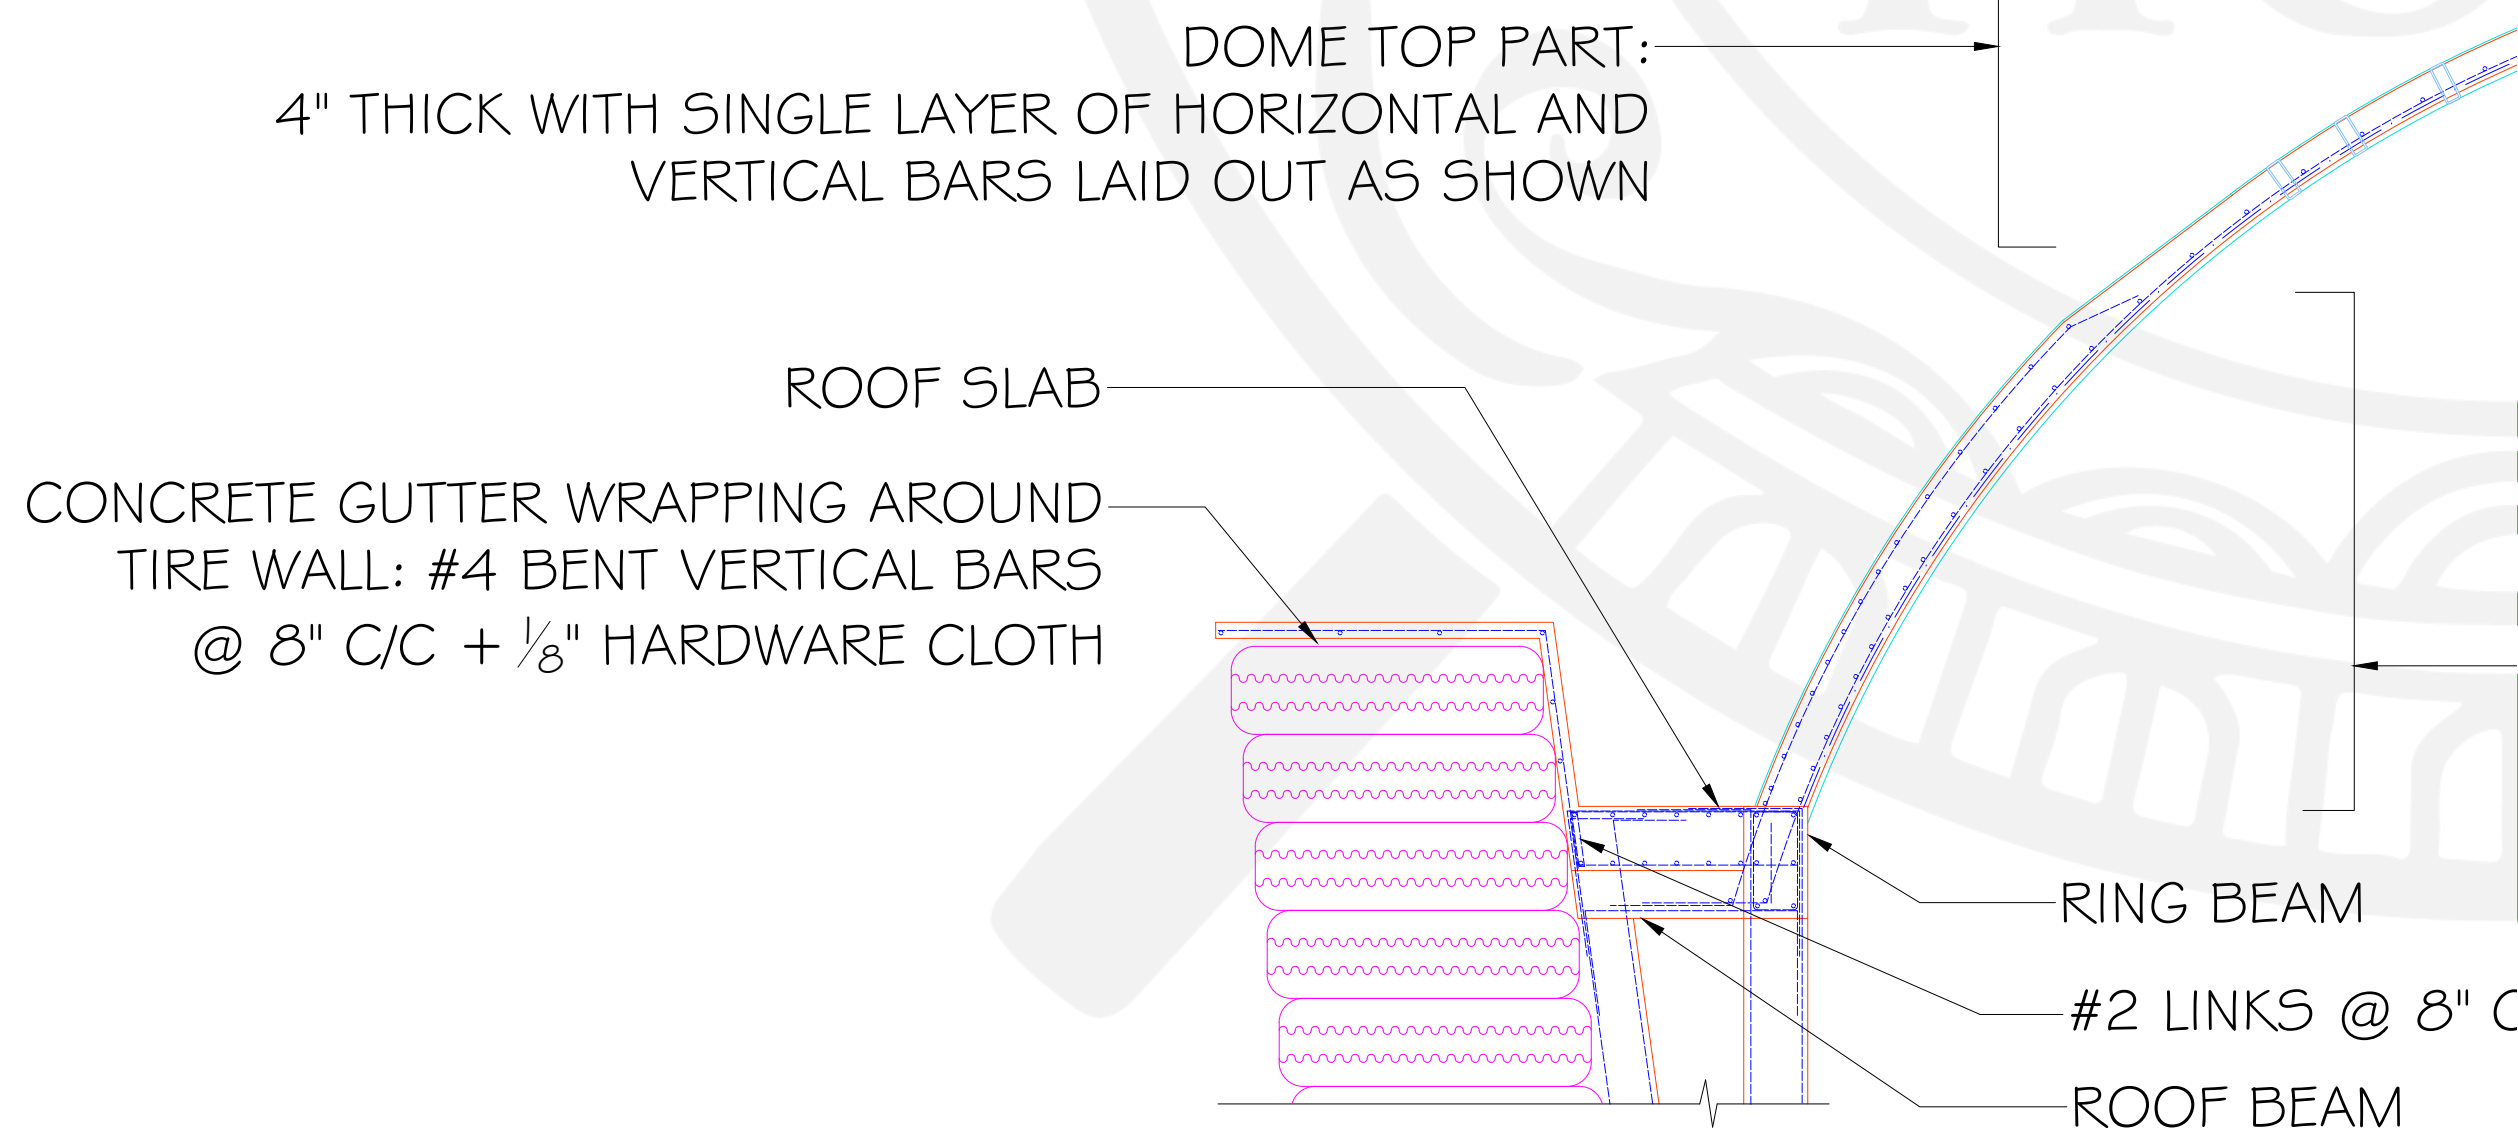

2 CONCRETE DOME W/ ROOF BEAM  
1/2" = 1' - 0"

## NOTES:

1. THIS DRAWING IS A CAD DRAWING AND SHOULD NOT BE ALTERED MANUALLY.
2. THIS DRAWING MUST NOT BE USED FOR CONSTRUCTION UNLESS APPROVED OTHERWISE.
3. ALL DRAWINGS SHALL BE READ IN CONJUNCTION WITH ALL OTHER CONSULTANTS DRAWINGS AND SPECIFICATIONS.
4. THIS DOCUMENT MAY ONLY BE USED BY LONG WAY HOME'S CLIENT (AND ANY OTHER PERSON WHO LWH HAS GIVEN PERMISSION TO USE THIS DOCUMENT) FOR THE PURPOSE FOR WHICH IT WAS PREPARED AND MUST NOT BE USED BY ANY OTHER PERSON OR FOR ANY OTHER PURPOSE.
5. THIS DRAWING IS PROTECTED BY INTERNATIONAL COPYRIGHT LAW.

### MATERIALS KEY:

- CONCRETE
- TIRE
- COB
- STEEL REINFORCEMENT
- GLASS

### REINFORCEMENT NOTES:

- ALL BARS ARE #4 BARS (UNLESS NOTED OTHERWISE)
- LINKS FOR COLUMNS + ROOF BEAMS ARE NOT SHOWN FOR CLARITY.
- ALL LINKS ARE #2 BARS @ 8" C/C

LONG WAY HOME  
SAN JUAN COMALAPA, GUATEMALA



WWW.LWHOME.ORG  
INFO@LWHOME.ORG

### PROJECT:

HERO SCHOOL



### BUILDING:

42,500 GALLON  
CISTERN +  
DOME LIBRARY

### NO:

8/11

### REVISIONS:

NO.	DATE	DESC	DRAWN BY
1	05/03/2015		M.F.
2	06/05/2021	AS BUILT	S.M.

### DRAWN BY:

GERMAIN HOT

### DATE:

06 MAY 2021

### SHEET TITLE:

CONCRETE DOME  
DETAILS

### SCALE:

1/2" = 1' - 0"

### SHEET SIZE:


A1

### SHEET NO.


8/11-403

PAGE 8  
OF 11




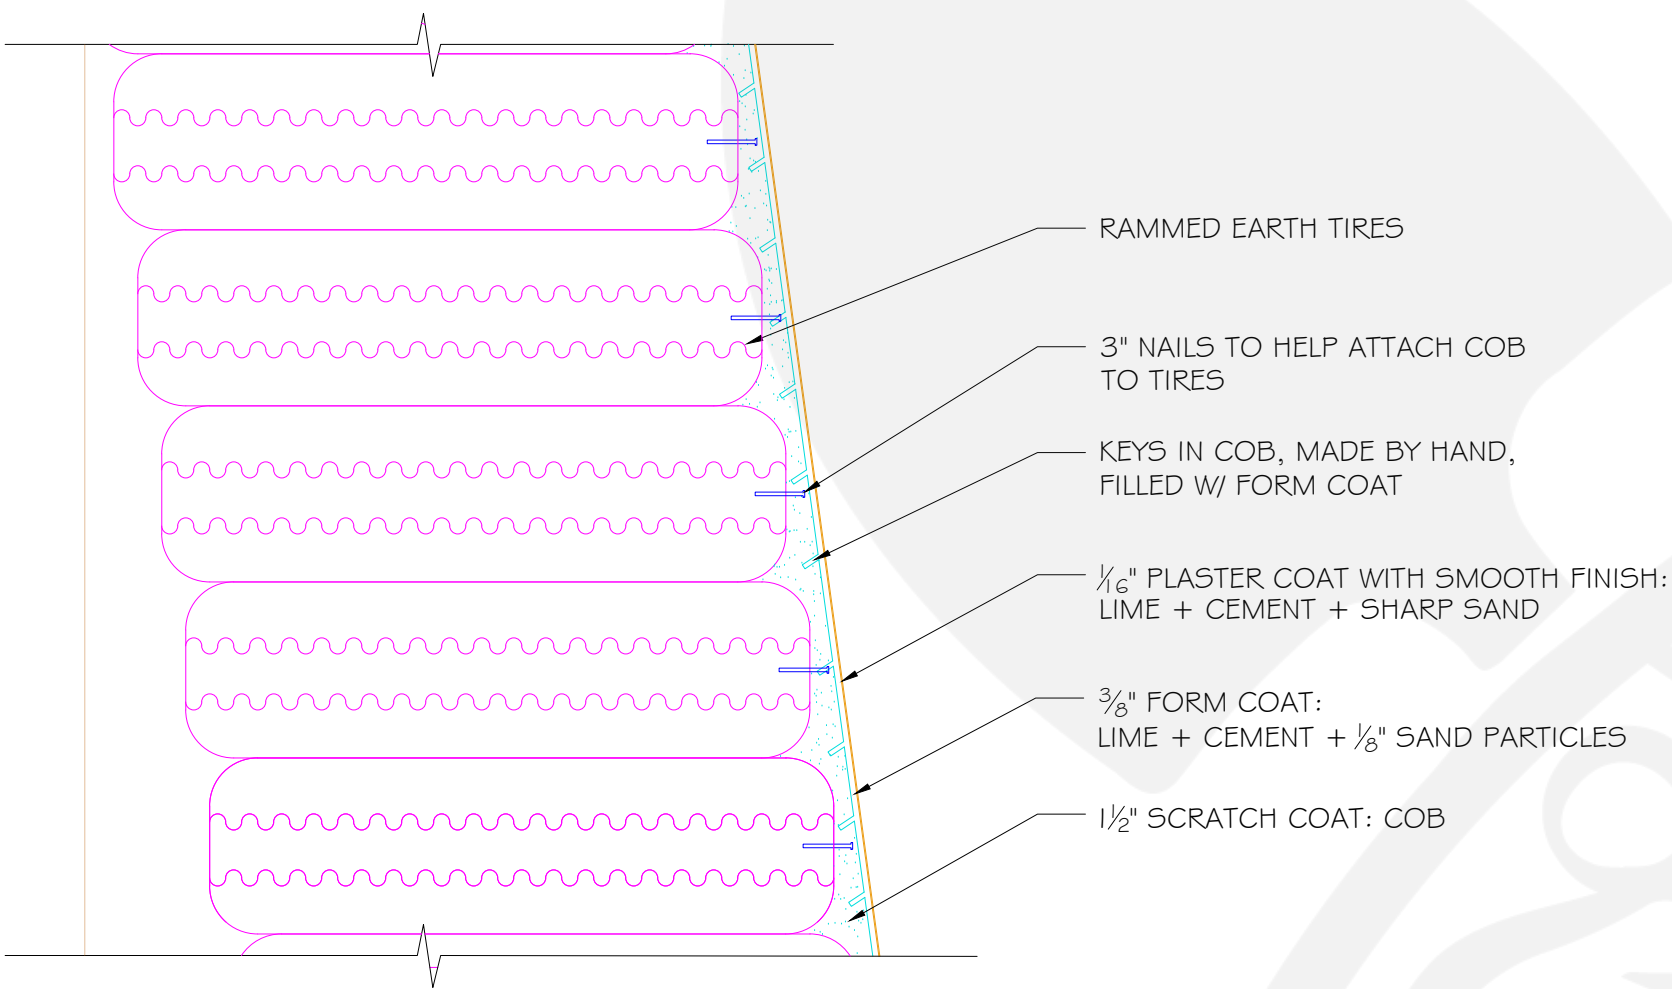


**A** WALL TYPE A  
8/11-405 1" = 1'-0"

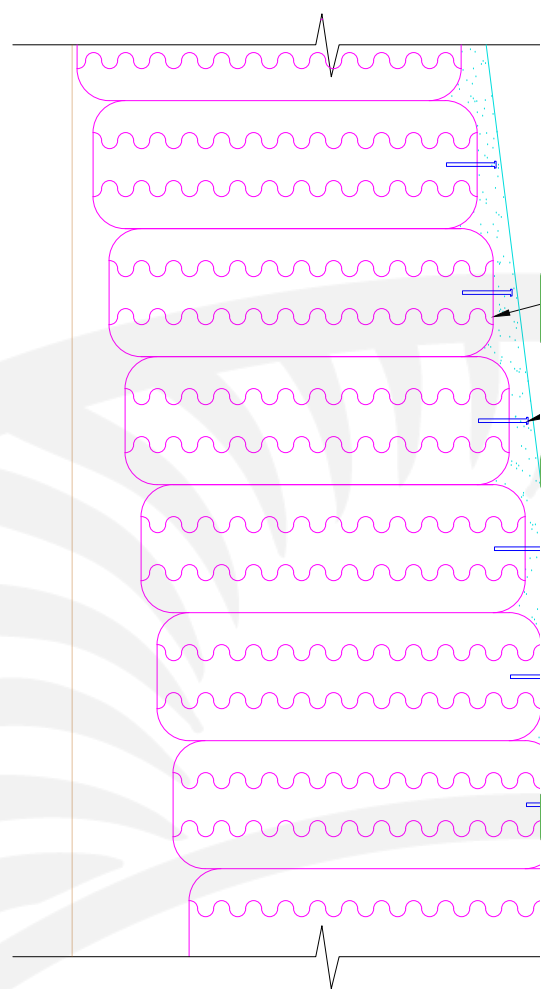

**B** WALL TYPE B  
8/11-405 1" = 1'-0"

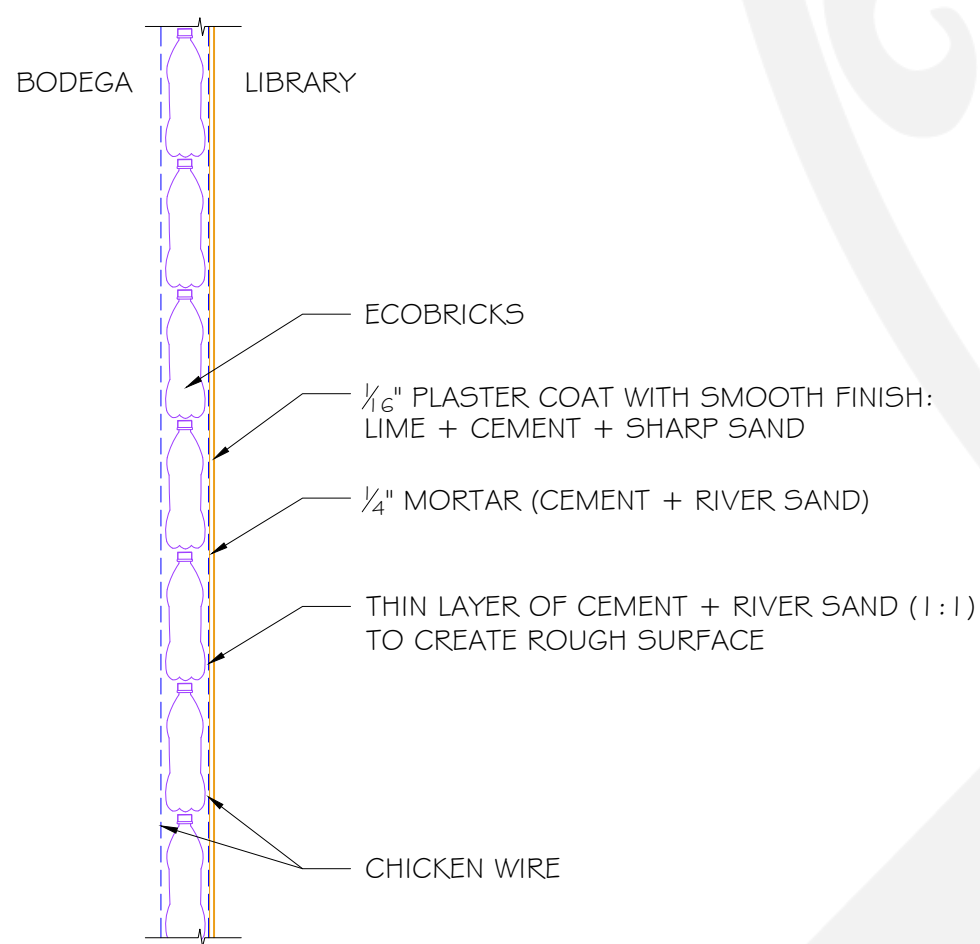

**D** WALL TYPE D  
8/11-405 1" = 1'-0"

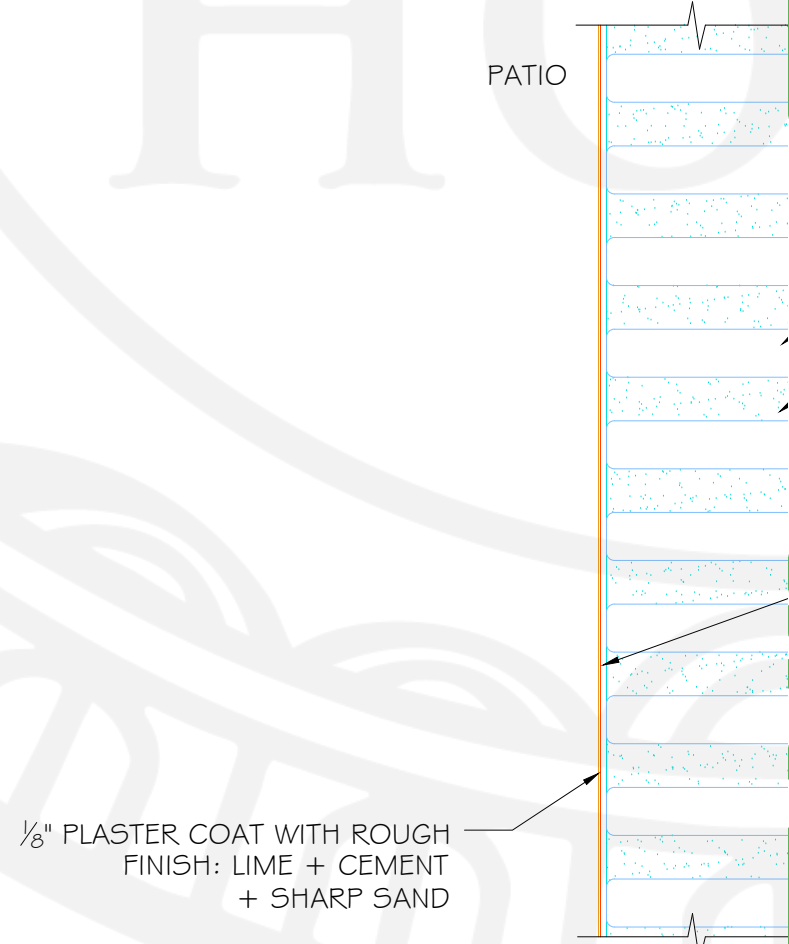

**E** WALL TYPE E  
8/11-405 1" = 1'-0"

## NOTES:

1. THIS DRAWING IS A CAD DRAWING AND SHOULD NOT BE ALTERED MANUALLY.
2. THIS DRAWING MUST NOT BE USED FOR CONSTRUCTION UNLESS APPROVED OTHERWISE.
3. ALL DRAWINGS SHALL BE READ IN CONJUNCTION WITH ALL OTHER CONSULTANTS DRAWINGS AND SPECIFICATIONS.
4. THIS DOCUMENT MAY ONLY BE USED BY LONG WAY HOME'S CLIENT (AND ANY OTHER PERSON WHO LWH HAS GIVEN PERMISSION TO USE THIS DOCUMENT) FOR THE PURPOSE FOR WHICH IT WAS PREPARED AND MUST NOT BE USED BY ANY OTHER PERSON OR FOR ANY OTHER PURPOSE.
5. THIS DRAWING IS PROTECTED BY INTERNATIONAL COPYRIGHT LAW.

### MATERIALS KEY:

- TIRE
- STEEL REINFORCEMENT
- GLASS
- PLASTIC
- EARTH
- COB
- SAND + CEMENT FINISHES

### WALL TYPES KEY:

- WALL TYPE A: RAMMED EARTH TIRES
- WALL TYPE B: RAMMED EARTH TIRES
- WALL TYPE C: GLASS BOTTLES + MORTAR
- WALL TYPE D: ECOBRICKS + MORTAR
- WALL TYPE E: COB + GLASS BOTTLES
- WALL TYPE F: ECOBRICKS + MORTAR

**LONG WAY HOME**  
SAN JUAN COMALAPA, GUATEMALA



WWW.LWHOME.ORG  
INFO@LWHOME.ORG

PROJECT:

**HERO SCHOOL**



BUILDING:  
42,500 GALLON  
CISTERN +  
DOME LIBRARY

NO:  
8/11

### REVISIONS:

NO.	DATE	DESC	DRAWN BY
1	05/03/2015		M.F.
2	06/05/2021	AS BUILT	S.M.

DRAWN BY:  
GERMAIN HOT

DATE:  
06 MAY 2021

SHEET TITLE:  
WALL TYPE DETAILS

SCALE:  
1" = 1'-0"


SHEET SIZE:  
A1

SHEET NO.


8/11-404

PAGE 9  
OF 11



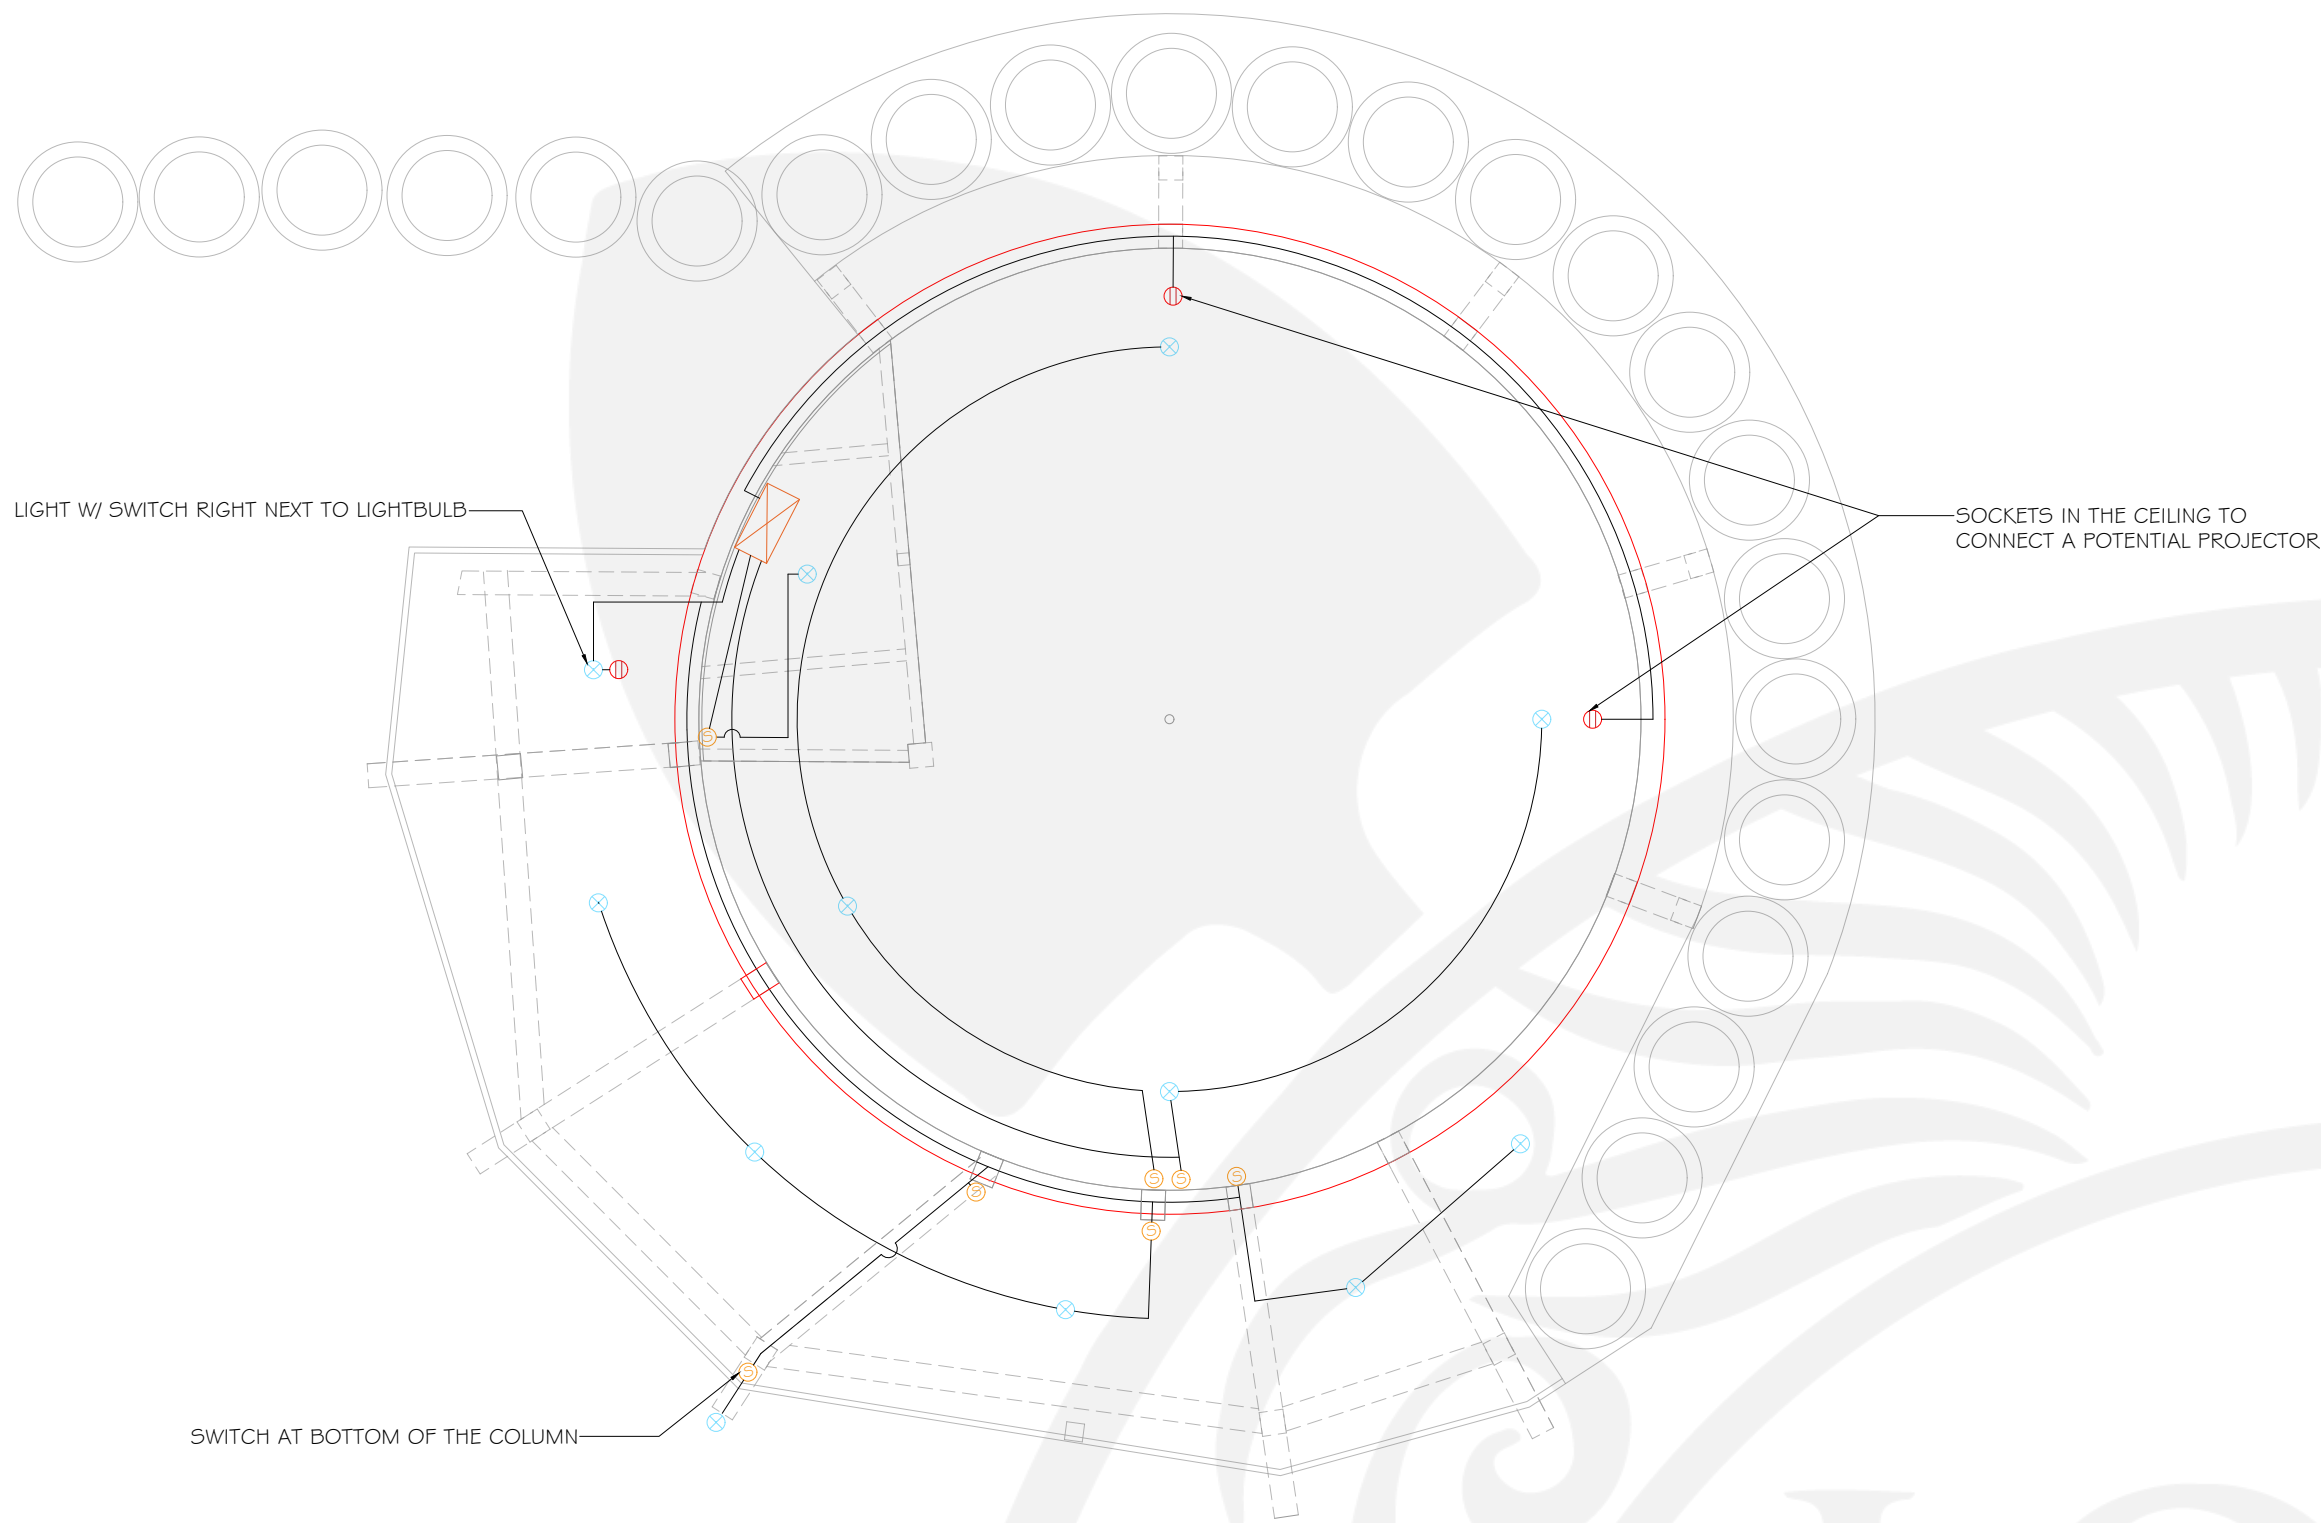

1 CEILING LIGHTS + OUTLETS  
3/16" = 1' - 0"

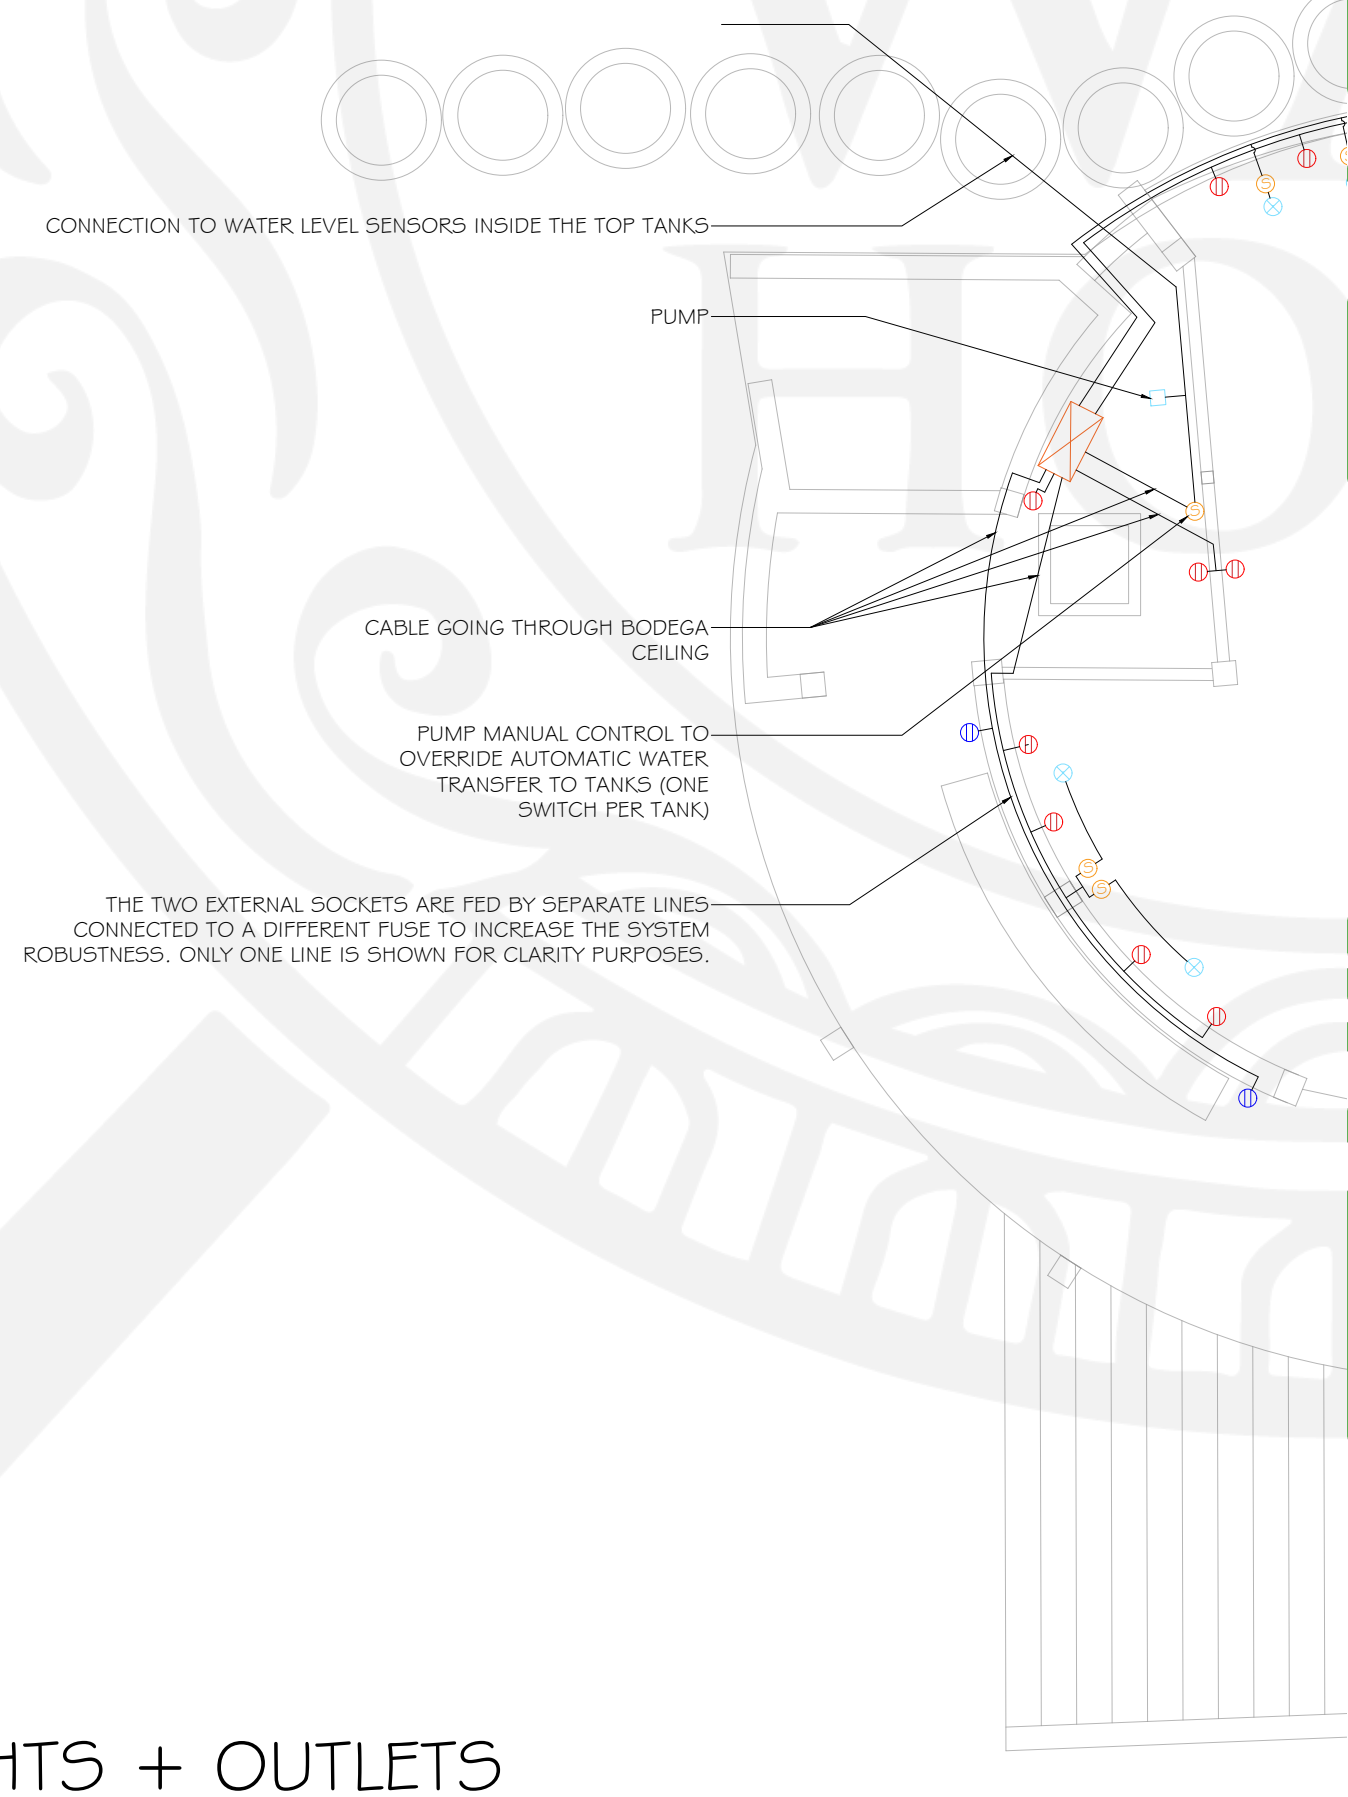


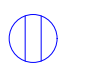




3 ADDITIONAL GROUND FLOOR LIGHTS + OUTLETS  
3/16" = 1' - 0"

## NOTES:

1. THIS DRAWING IS A CAD DRAWING AND SHOULD NOT BE ALTERED MANUALLY.
2. THIS DRAWING MUST NOT BE USED FOR CONSTRUCTION UNLESS APPROVED OTHERWISE.
3. ALL DRAWINGS SHALL BE READ IN CONJUNCTION WITH ALL OTHER CONSULTANTS DRAWINGS AND SPECIFICATIONS.
4. THIS DOCUMENT MAY ONLY BE USED BY LONG WAY HOME'S CLIENT (AND ANY OTHER PERSON WHO LWH HAS GIVEN PERMISSION TO USE THIS DOCUMENT) FOR THE PURPOSE FOR WHICH IT WAS PREPARED AND MUST NOT BE USED BY ANY OTHER PERSON OR FOR ANY OTHER PURPOSE.
5. THIS DRAWING IS PROTECTED BY INTERNATIONAL COPYRIGHT LAW.

### ELECTRICITY KEY:

-  SWITCH
-  LIGHT
-  OUTLET HIGH LEVEL (ABOUT 1 M ABOVE GROUND)
-  OUTLET LOW LEVEL (ABOUT 0.2 M ABOVE GROUND)
-  MAIN FEED
-  FUSE BOX

ON GF ALL SOCKETS ARE LOCATED ABOVE THE TABLE LEVEL IN PRESENCE OF A TABLE.

ALL LIGHTS ARE SHEDDING LIGHT ON TABLES OR SHELVES.

LONG WAY HOME  
SAN JUAN COMALAPA, GUATEMALA



WWW.LWHOME.ORG  
INFO@LWHOME.ORG

PROJECT:

HERO SCHOOL



BUILDING:

42,500 GALLON  
CISTERN +  
DOME LIBRARY

NO:

8/11

### REVISIONS:

NO.	DATE	DESC	DRAWN BY
1	05/03/2015		M.F.
2	06/05/2021	AS BUILT	S.M.

DRAWN BY:

GERMAIN HOT

DATE:

06 MAY 2021

SHEET TITLE:

ELECTRICITY PLANS

SCALE:

3/16" = 1'-0"

SHEET SIZE:

A1

SHEET NO.

8/11-500

PAGE 10  
OF 11





**I** ROOF DRAINAGE PLAN  
3/8" = 1'-0"

**NOTES:**

1. THIS DRAWING IS A CAD DRAWING AND SHOULD NOT BE ALTERED MANUALLY.
2. THIS DRAWING MUST NOT BE USED FOR CONSTRUCTION UNLESS APPROVED OTHERWISE.
3. ALL DRAWINGS SHALL BE READ IN CONJUNCTION WITH ALL OTHER CONSULTANTS DRAWINGS AND SPECIFICATIONS.
4. THIS DOCUMENT MAY ONLY BE USED BY LONG WAY HOME'S CLIENT (AND ANY OTHER PERSON WHO LWH HAS GIVEN PERMISSION TO USE THIS DOCUMENT) FOR THE PURPOSE FOR WHICH IT WAS PREPARED AND MUST NOT BE USED BY ANY OTHER PERSON OR FOR ANY OTHER PURPOSE.
5. THIS DRAWING IS PROTECTED BY INTERNATIONAL COPYRIGHT LAW.

**WATER MANAGEMENT KEY:**

→ → → → → DENOTES DRAINAGE FLOW OF RAINWATER

**LONG WAY HOME**  
SAN JUAN COMALAPA, GUATEMALA



WWW.LWHOME.ORG  
INFO@LWHOME.ORG

**PROJECT:**

**HERO SCHOOL**



**HERO SCHOOL**

**BUILDING:** 42,500 GALLON CISTERN + DOME LIBRARY

**NO:** 8/11

REVISIONS:			
NO.	DATE	DESC	DRAWN BY
1	05/03/2015		M.F.
2	06/05/2021	AS BUILT	S.M.

**DRAWN BY:**  
GERMAIN HOT

**DATE:**  
06 MAY 2021

**SHEET TITLE:**  
ROOF DRAINAGE PLAN

**SCALE:** 3/8" = 1'-0" **SHEET SIZE:** A1

**SHEET NO.** 8/11-600 **PAGE 11 OF 11**