

GROUND FLOOR INTERIOR AREA: 1,300 SQ FT
 COVERED PATIO AREA: 1,770 SQ FT
 TOTAL AREA: 3,070 SQ FT



1 GROUND FLOOR PLAN
 3/16" = 1'-0"

NOTES:

1. THIS DRAWING IS A CAD DRAWING AND SHOULD NOT BE ALTERED MANUALLY.
2. THIS DRAWING MUST NOT BE USED FOR CONSTRUCTION UNLESS APPROVED OTHERWISE.
3. ALL DRAWINGS SHALL BE READ IN CONJUNCTION WITH ALL OTHER CONSULTANTS DRAWINGS AND SPECIFICATIONS.
4. THIS DOCUMENT MAY ONLY BE USED BY LONG WAY HOME'S CLIENT (AND ANY OTHER PERSON WHO LWH HAS GIVEN PERMISSION TO USE THIS DOCUMENT) FOR THE PURPOSE FOR WHICH IT WAS PREPARED AND MUST NOT BE USED BY ANY OTHER PERSON OR FOR ANY OTHER PURPOSE.
5. THIS DRAWING IS PROTECTED BY INTERNATIONAL COPYRIGHT LAW.

MATERIALS KEY:

- CONCRETE
- TIRE
- ECOBRICKS
- COB
- EARTH
- PLASTIC
- PROPERTY SEPARATION
- PAPER-CEMENT FIBER
- GLASS
- OTHER

CUT AT TOP OF CONCRETE SLAB

LONG WAY HOME
 SAN JUAN COMALAPA, GUATEMALA



WWW.LWHOME.ORG
 INFO@LWHOME.ORG

PROJECT:

HERO SCHOOL



BUILDING:

NO: 1.2
 OVAL SHAPED
 TIRE CLASSROOMS
 "A 4-7"

REVISIONS:

NO.	DATE	DESC	DRAWN BY
1	27/06/2021	AS BUILT	S.M.

DRAWN BY:

GERMAIN HOT

DATE:

27 JUNE 2021

SHEET TITLE:

GROUND FLOOR PLAN

SCALE:

3/16" = 1'-0"


SHEET SIZE:

A1

SHEET NO.:

12-100

GROUND FLOOR INTERIOR AREA: 1,300 SQ FT
 COVERED PATIO AREA: 1,770 SQ FT
 TOTAL AREA: 3,070 SQ FT

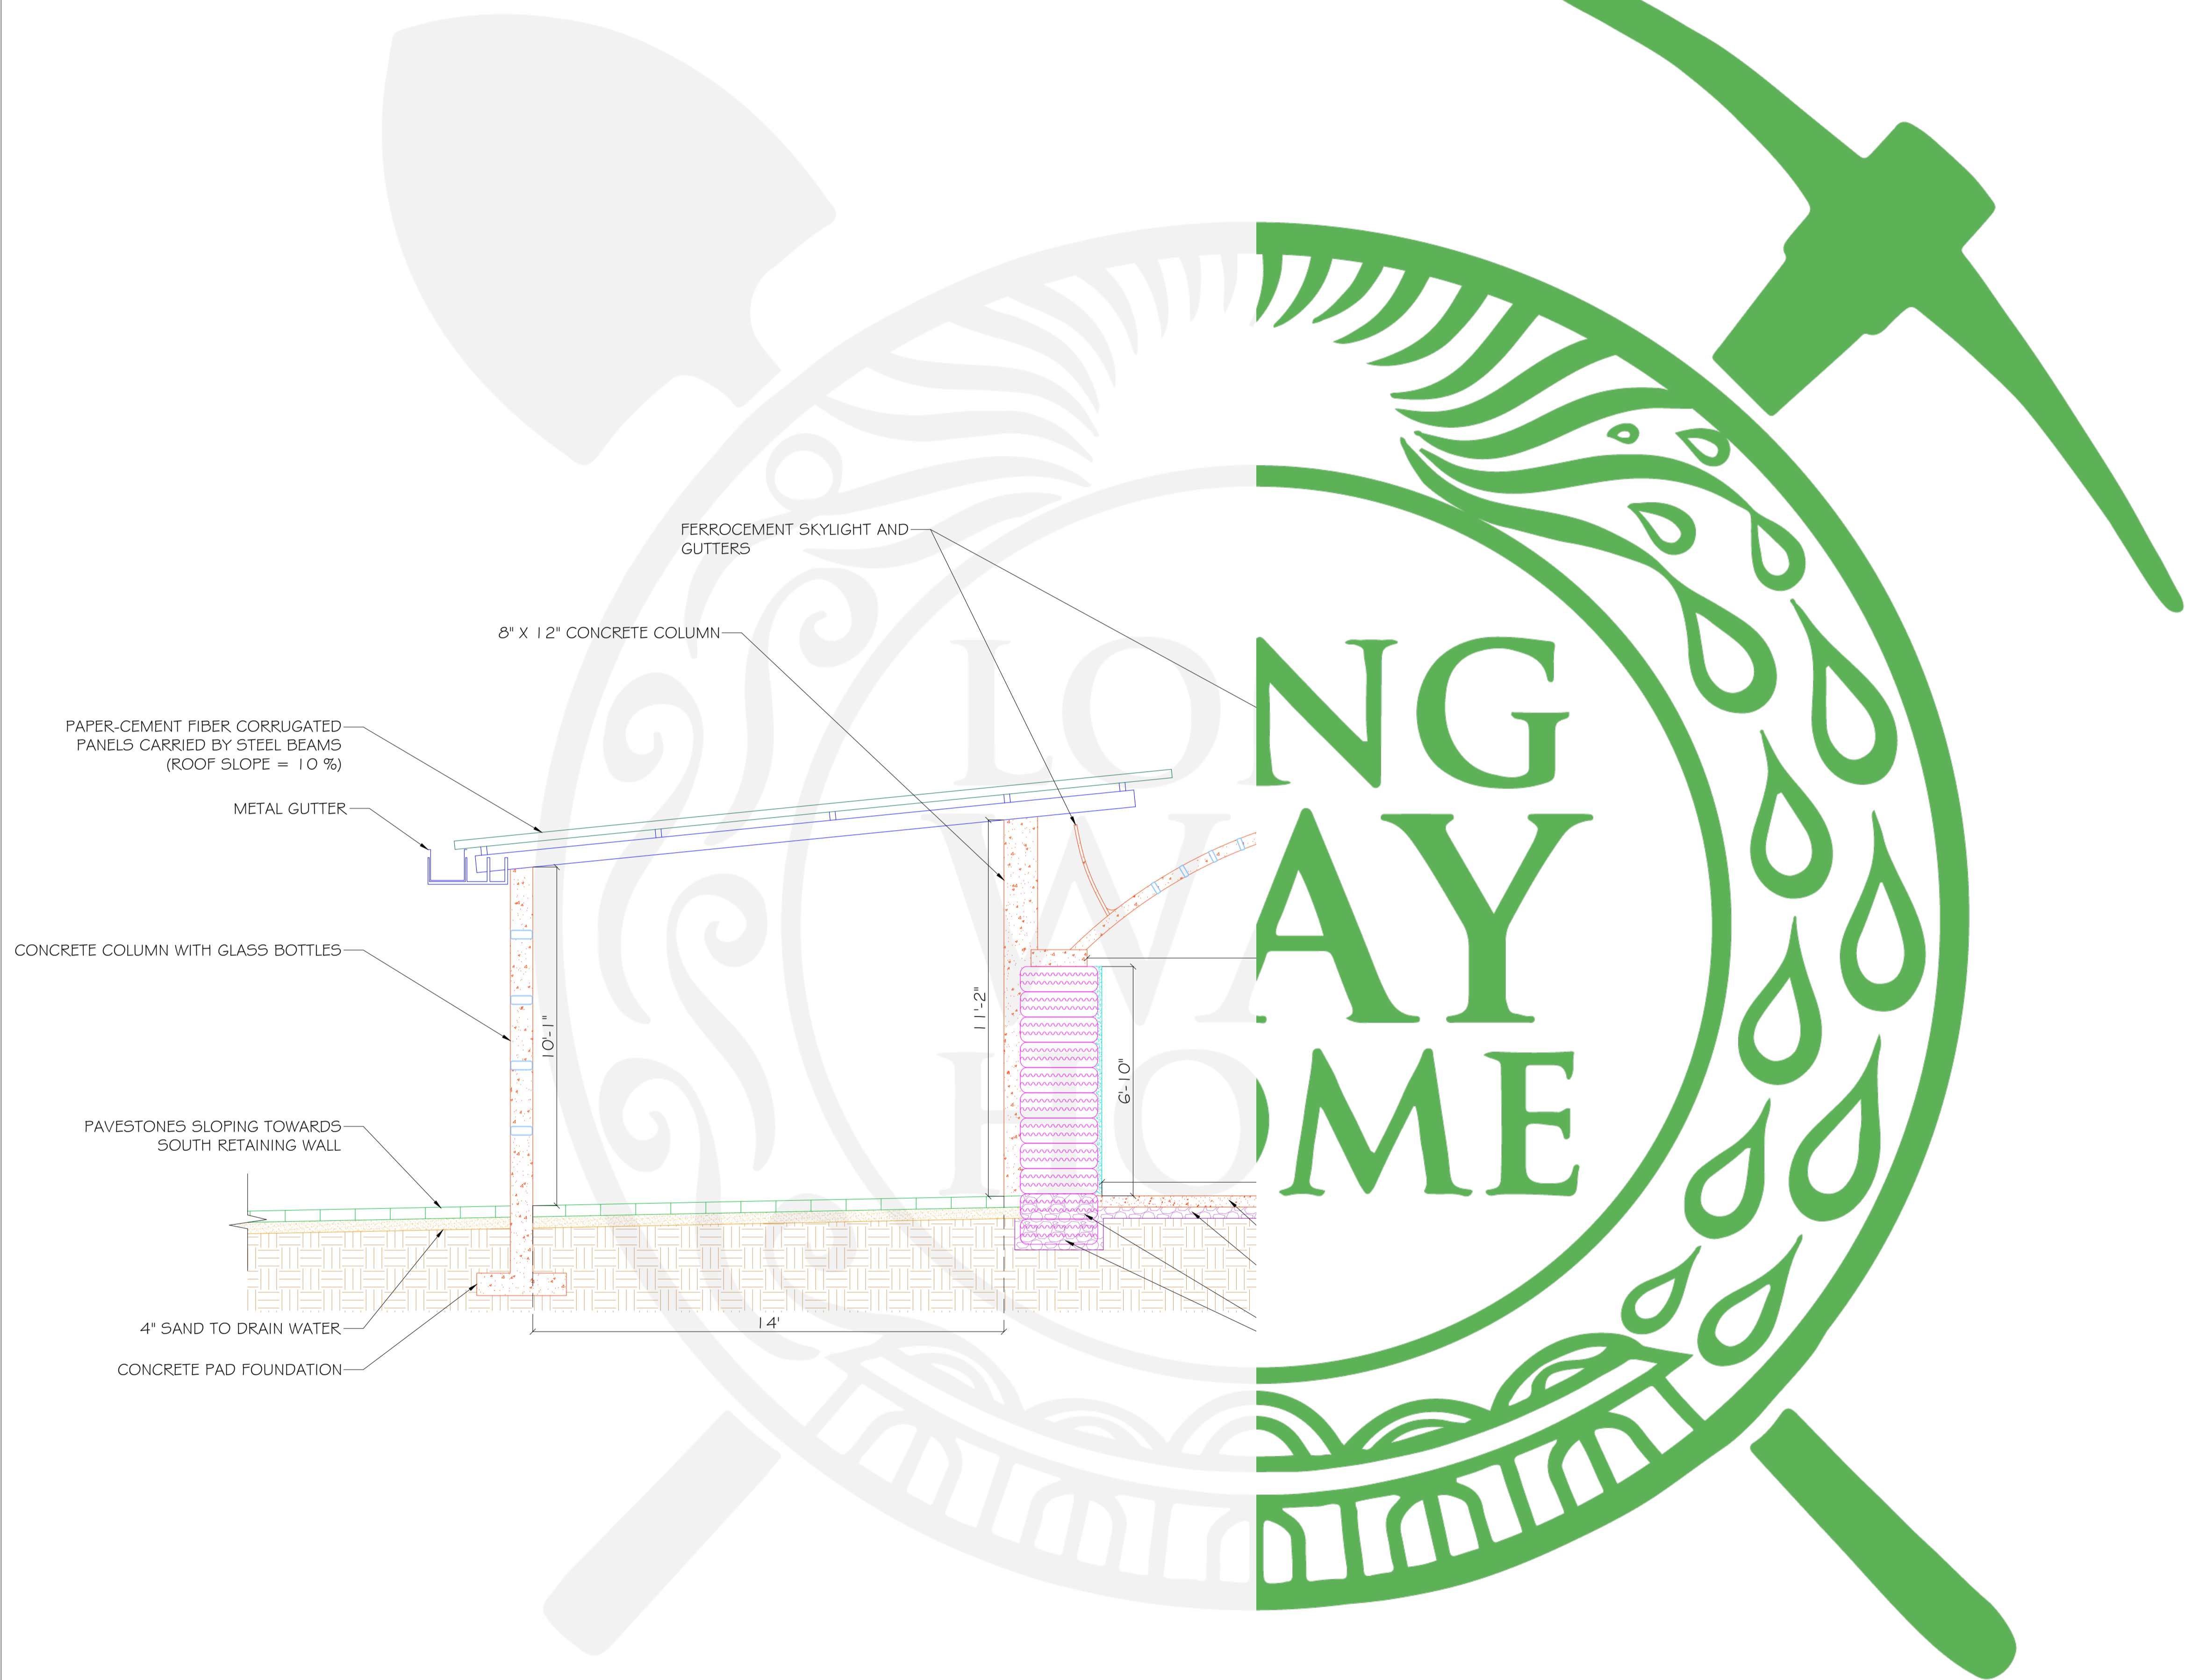

SECTION A
 3/8" = 1'-0"

NOTES:

1. THIS DRAWING IS A CAD DRAWING AND SHOULD NOT BE ALTERED MANUALLY.
2. THIS DRAWING MUST NOT BE USED FOR CONSTRUCTION UNLESS APPROVED OTHERWISE.
3. ALL DRAWINGS SHALL BE READ IN CONJUNCTION WITH ALL OTHER CONSULTANTS DRAWINGS AND SPECIFICATIONS.
4. THIS DOCUMENT MAY ONLY BE USED BY LONG WAY HOME'S CLIENT (AND ANY OTHER PERSON WHO LWH HAS GIVEN PERMISSION TO USE THIS DOCUMENT) FOR THE PURPOSE FOR WHICH IT WAS PREPARED AND MUST NOT BE USED BY ANY OTHER PERSON OR FOR ANY OTHER PURPOSE.
5. THIS DRAWING IS PROTECTED BY INTERNATIONAL COPYRIGHT LAW.

MATERIALS KEY:

- CONCRETE
- TIRE
- COB
- STEEL
- PROPERTY SEPARATION
- PAPER-CEMENT FIBER
- GLASS
- FILTER FABRIC
- UNDISTURBED EARTH
- BACKFILLED EARTH
- PAVESTONES
- SAND
- GRAVEL

LONG WAY HOME
 SAN JUAN COMALAPA, GUATEMALA



WWW.LWHOME.ORG
 INFO@LWHOME.ORG

PROJECT:
HERO SCHOOL
 HERO SCHOOL

BUILDING:
 OVAL SHAPED
 TIRE CLASSROOMS
 "A 4-7"

NO:
 12

REVISIONS:			
NO.	DATE	DESC	DRAWN BY
1	27/06/2021	AS BUILT	S.M.

DRAWN BY:
 GERMAIN HOT

DATE:
 27 JUNE 2021

SHEET TITLE:
 SECTION A

SCALE:
 3/8" = 1'-0"

SHEET SIZE:
 A1

SHEET NO.
 12-200

PAGE 2 OF 2